
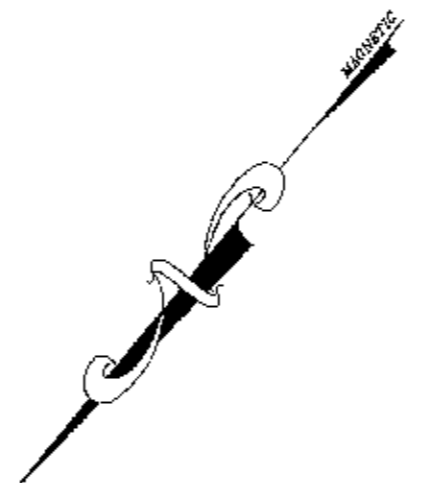


107x73


107x73

# CONDOMINIUM PLAT OF DORSEY VILLAGE BUILDING 11

37x701

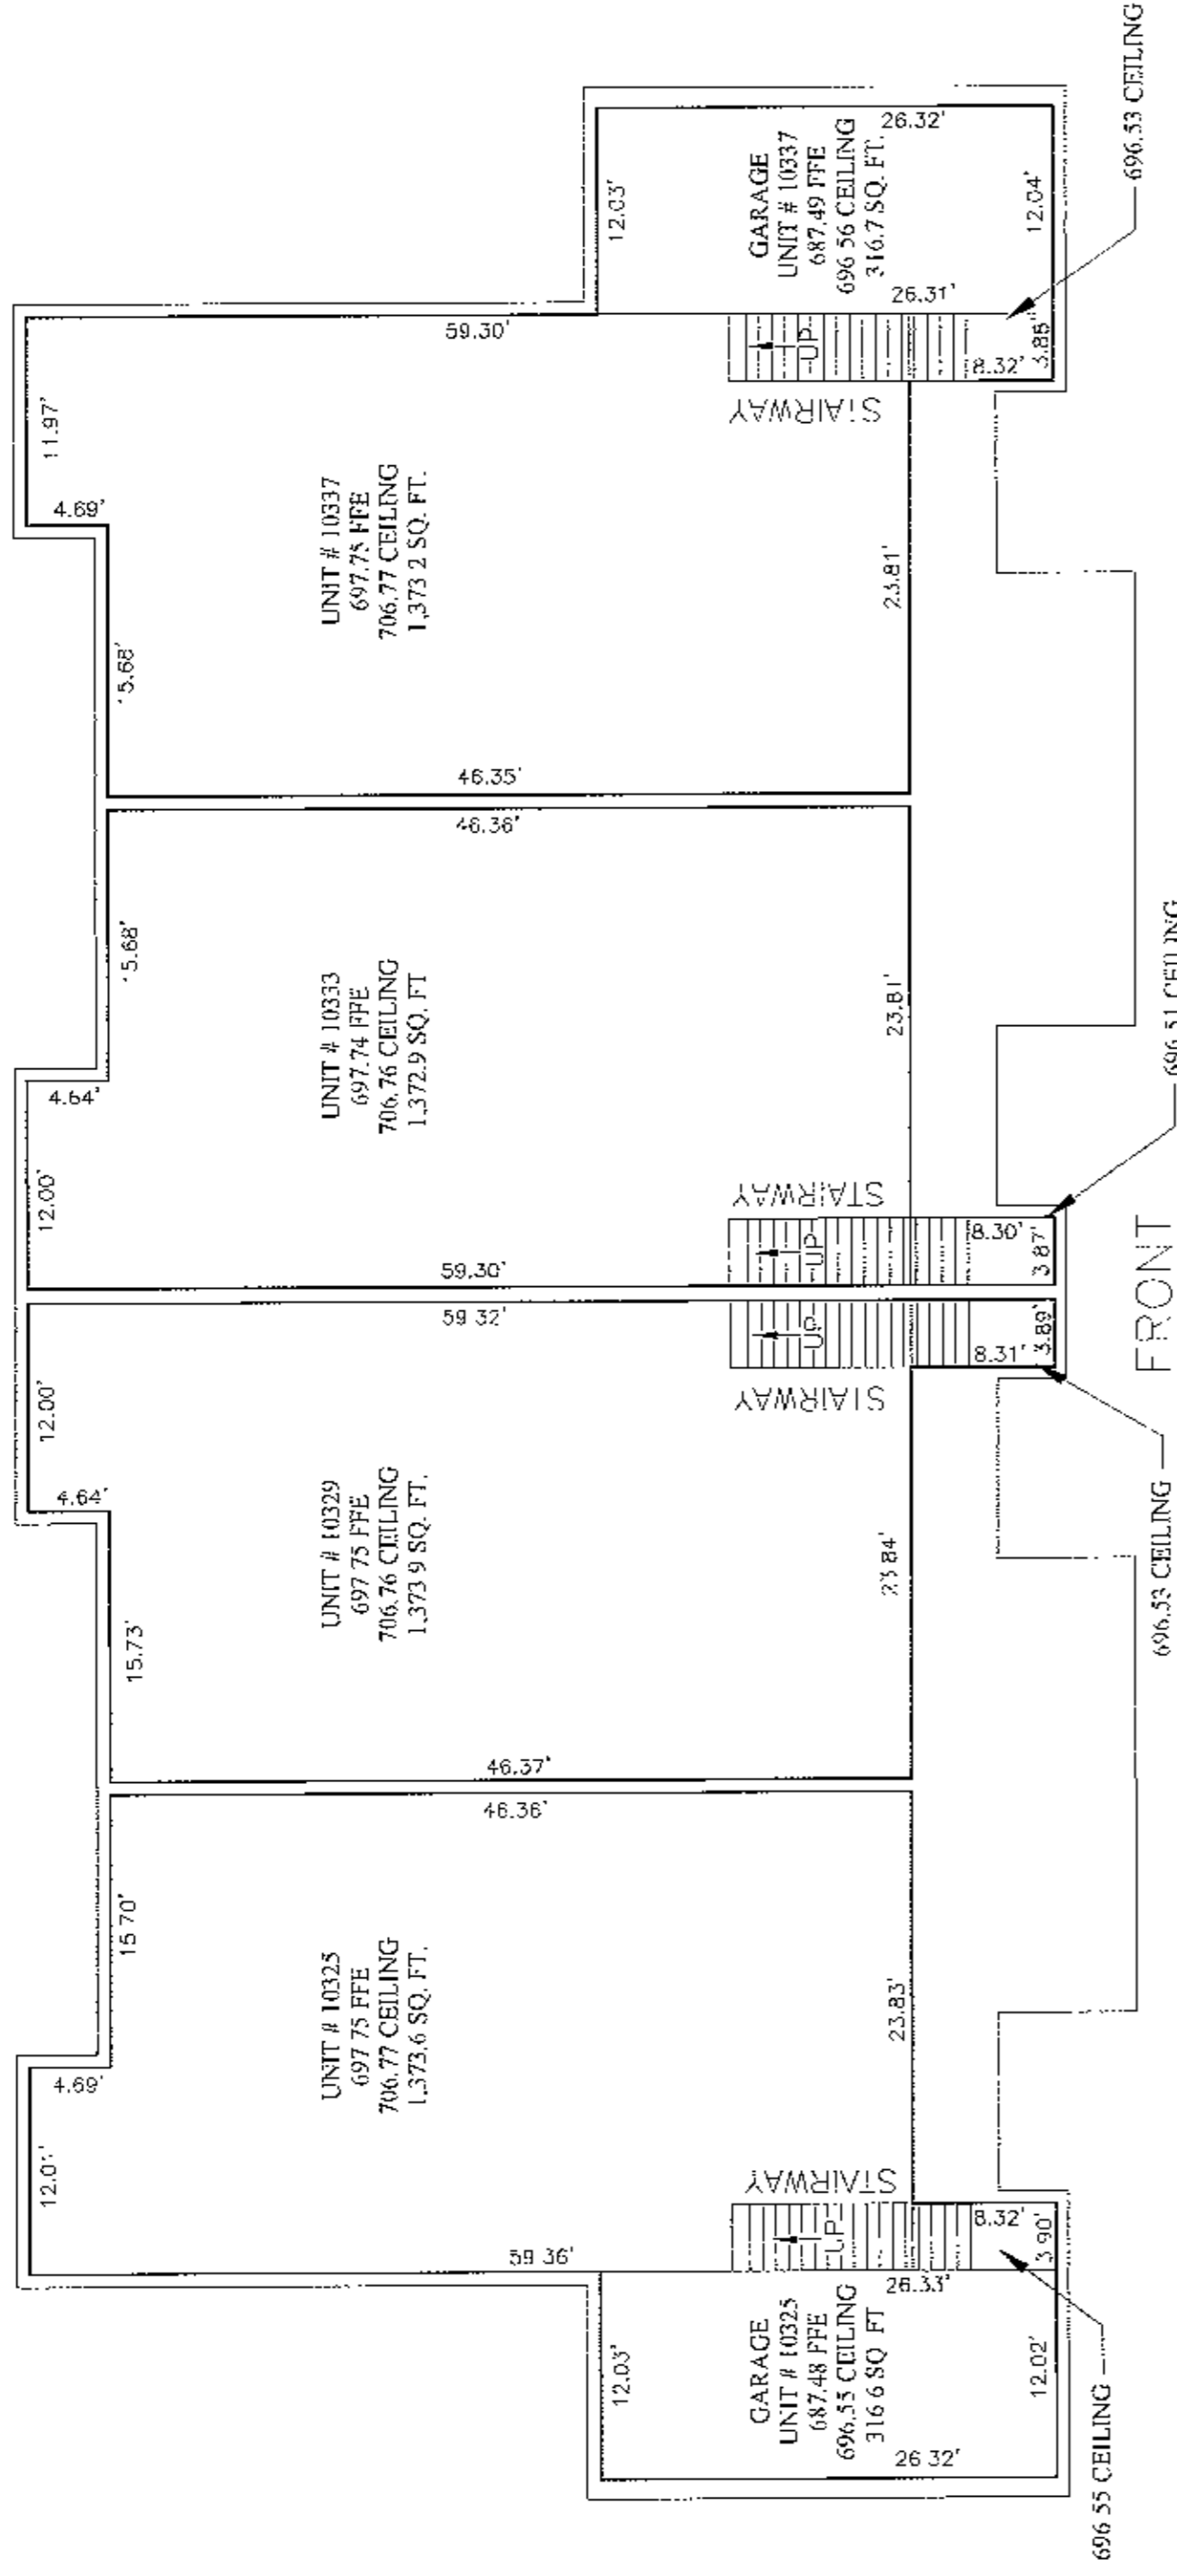

SECOND FLOOR UNITS BUILDING 11

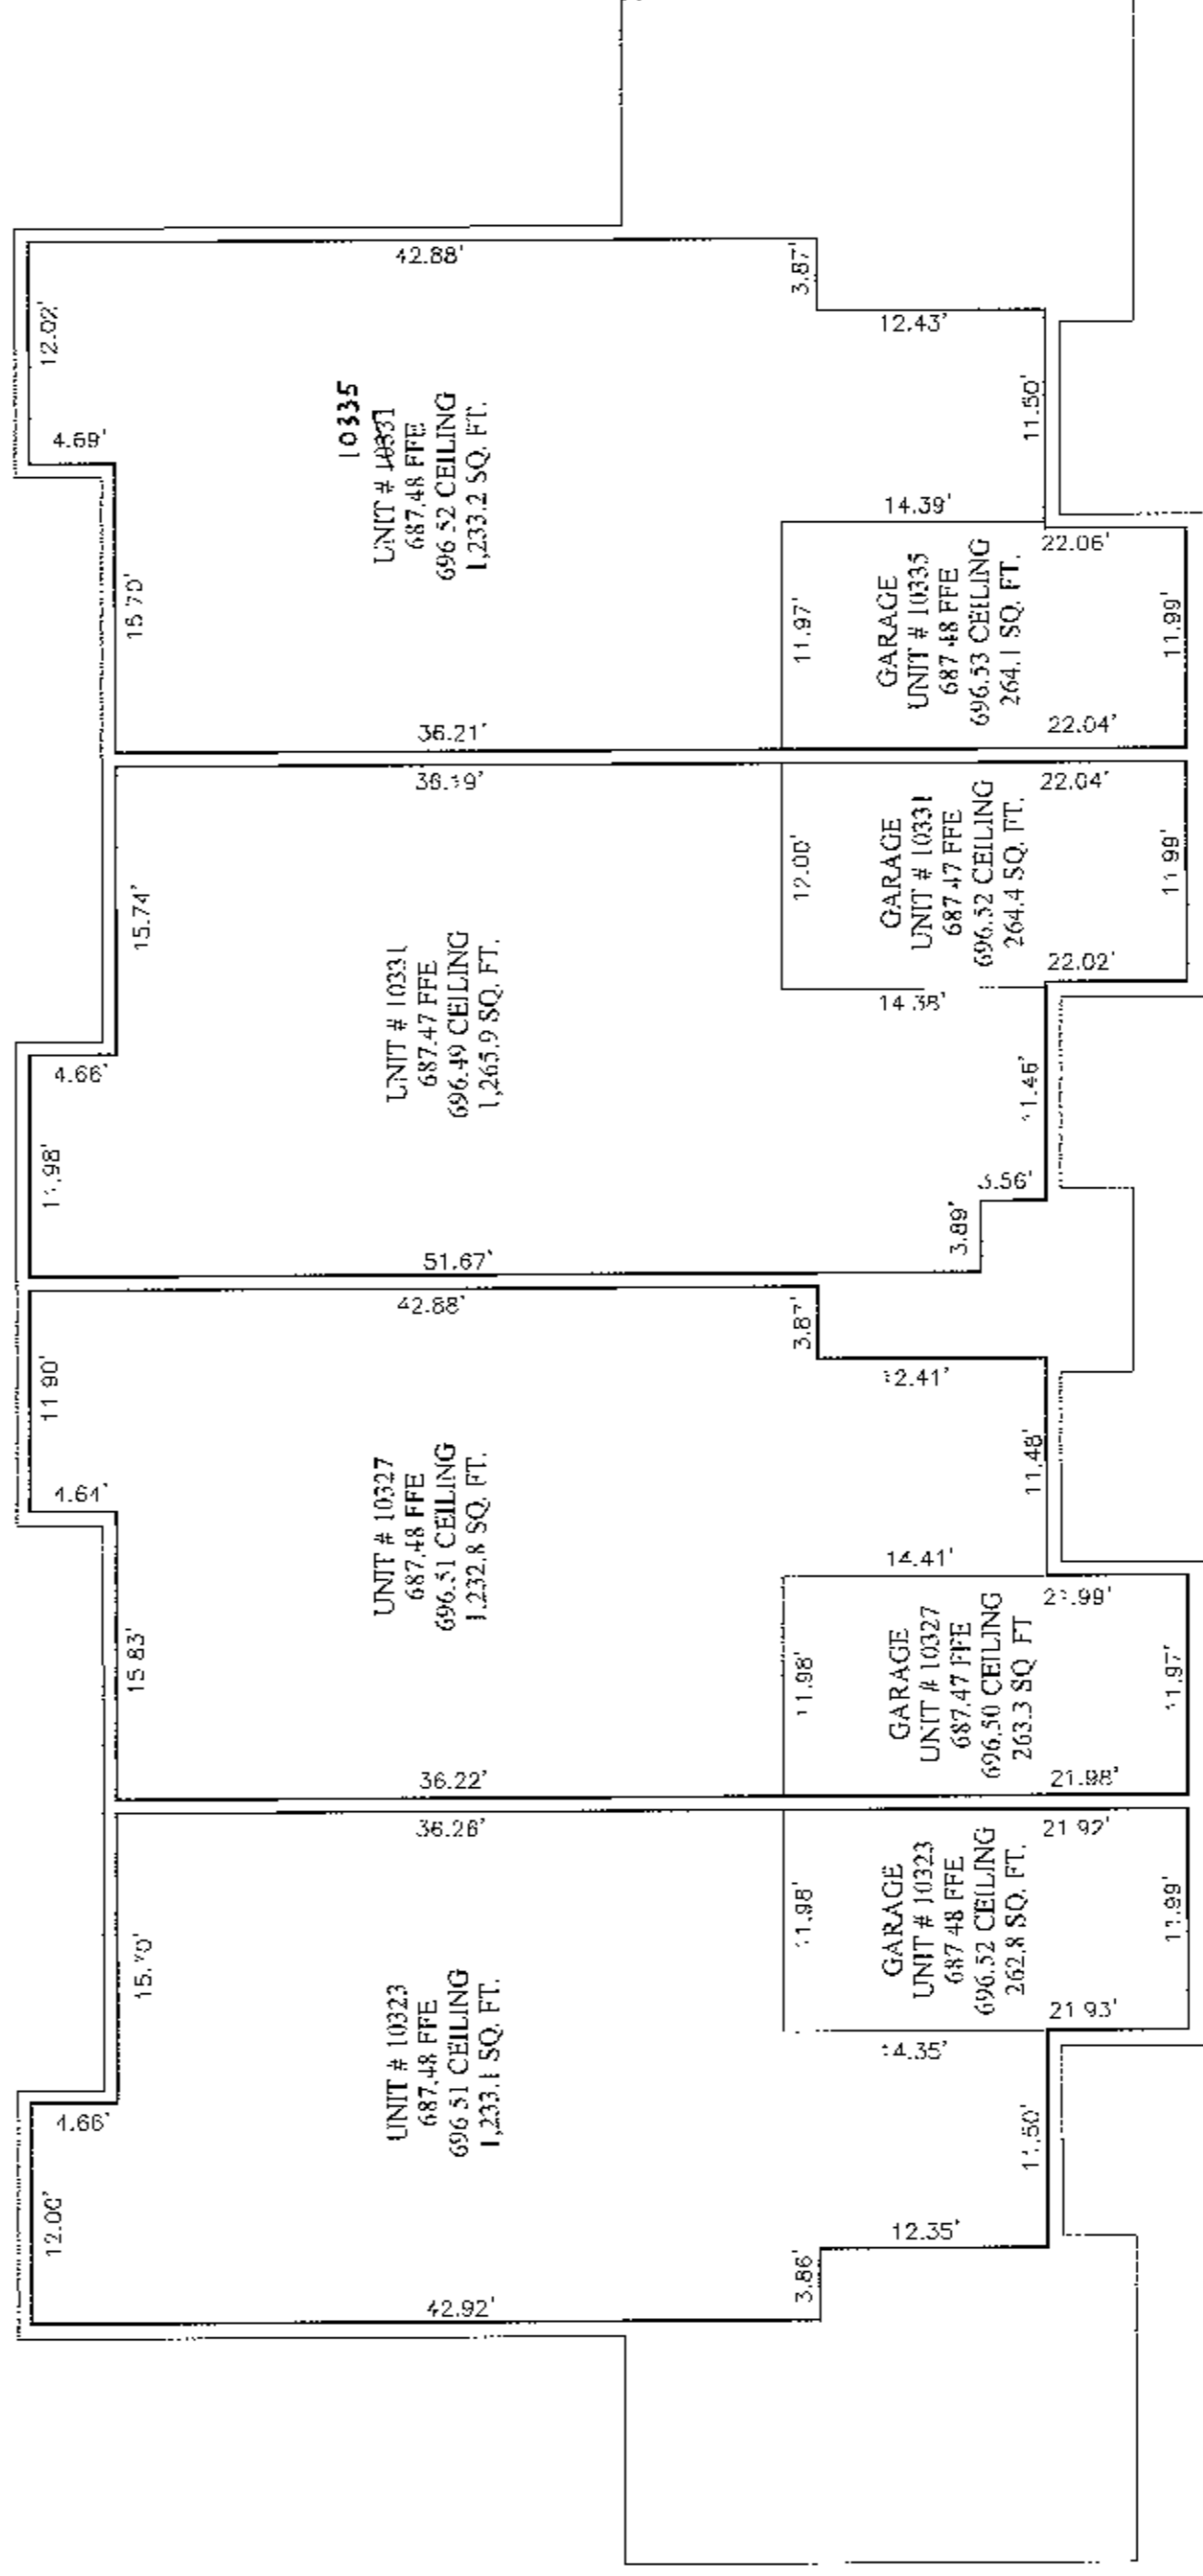



FRONT

FIRST FLOOR UNITS BUILDING 11

### SURVEYOR'S CERTIFICATE

I, JAMES F. CROWM, A PROFESSIONAL LAND SURVEYOR IN THE STATE OF KENTUCKY, DO HEREBY CERTIFY THAT THIS SURVEY WAS MADE, BY ME, OR UNDER MY CLOSE PERSONAL SUPERVISION AND CONTROL, IN ACCORDANCE WITH THE PROVISIONS OF THE KENTUCKY SURVEYING ACTS, AND THAT THE DIMENSIONS, BEARINGS, AND TEMPERATURES FULLY AND ACCURATELY DEPICT THE LAYOUT, LOCATION, UNIT NUMBERS, AND DIMENSIONS OF THE UNITS AS BUILT AS REQUIRED BY KRS 381.83, AMENDED 1998 KY ACTS CH. 24, SEC. 41.

*James F. Crowm*  
 SIGNATURE  
 3189  
 P. SH  
 3-29-05  
 Date

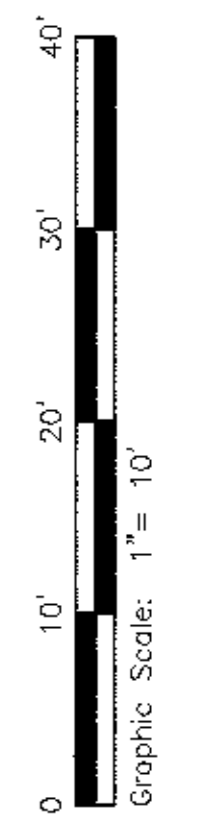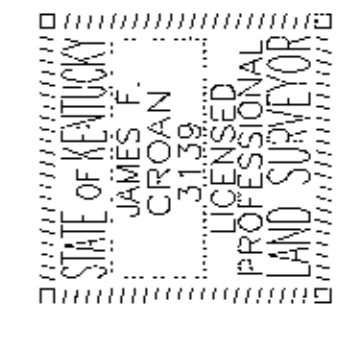

08603P60157

Recorded in Office Book  
 No. 101 Page 13  
 Part No. 1005

Owner  
 DORSEY VILLAGE, LLC  
 DEED BOOK 8891, PAGE 480

Developer  
 DORSEY VILLAGE, LLC

Owner  
 DORSEY VILLAGE, LLC  
 DEED BOOK 8891, PAGE 480

Surveyor  
 CROWM LAND SURVEYING  
 503 MEMPHIS DRIVE  
 TAYLORSVILLE, KY 40071  
 (502) 976-9958

© COPYRIGHT 2003  
 CROWM LAND SURVEYING  
 ALL RIGHTS RESERVED

PROJECT NO.: 05-040 DRAWN BY: JFC SCALE: 1" = 10' DATE: 3/29/05 SHEET: 2 OF 2

107x73

107 x 74

# DORSEY VILLAGE CONDOMINIUM PLAT


00503P60157

Recorded in Colorado Book  
101 Page 74  
Part No. 195

REVISIONS	
DEVELOPER	DORSEY VILLAGE, LLC
OWNER	DORSEY VILLAGE, LLC
	DEED BOOK 8391, PAGE 460
	CREAN, LAND SURVEYING
	588 MADISONVILLE DRIVE
	TAYLORSVILLE, KY 40071
	(502) 879-9858
	© COPYRIGHT 2007
	CREAN LAND SURVEYING
	ALL RIGHTS RESERVED
PROJECT NO.	05-040
DRAWN BY	JFC
SCALE	1" = 50'
DATE	3/29/05
SHEET	1 OF 2

**BUD**  
Before 'U' Dig  
CALL TOLL FREE  
1-800-752-6007  
For Billed Line/Other Locations

107 x 74

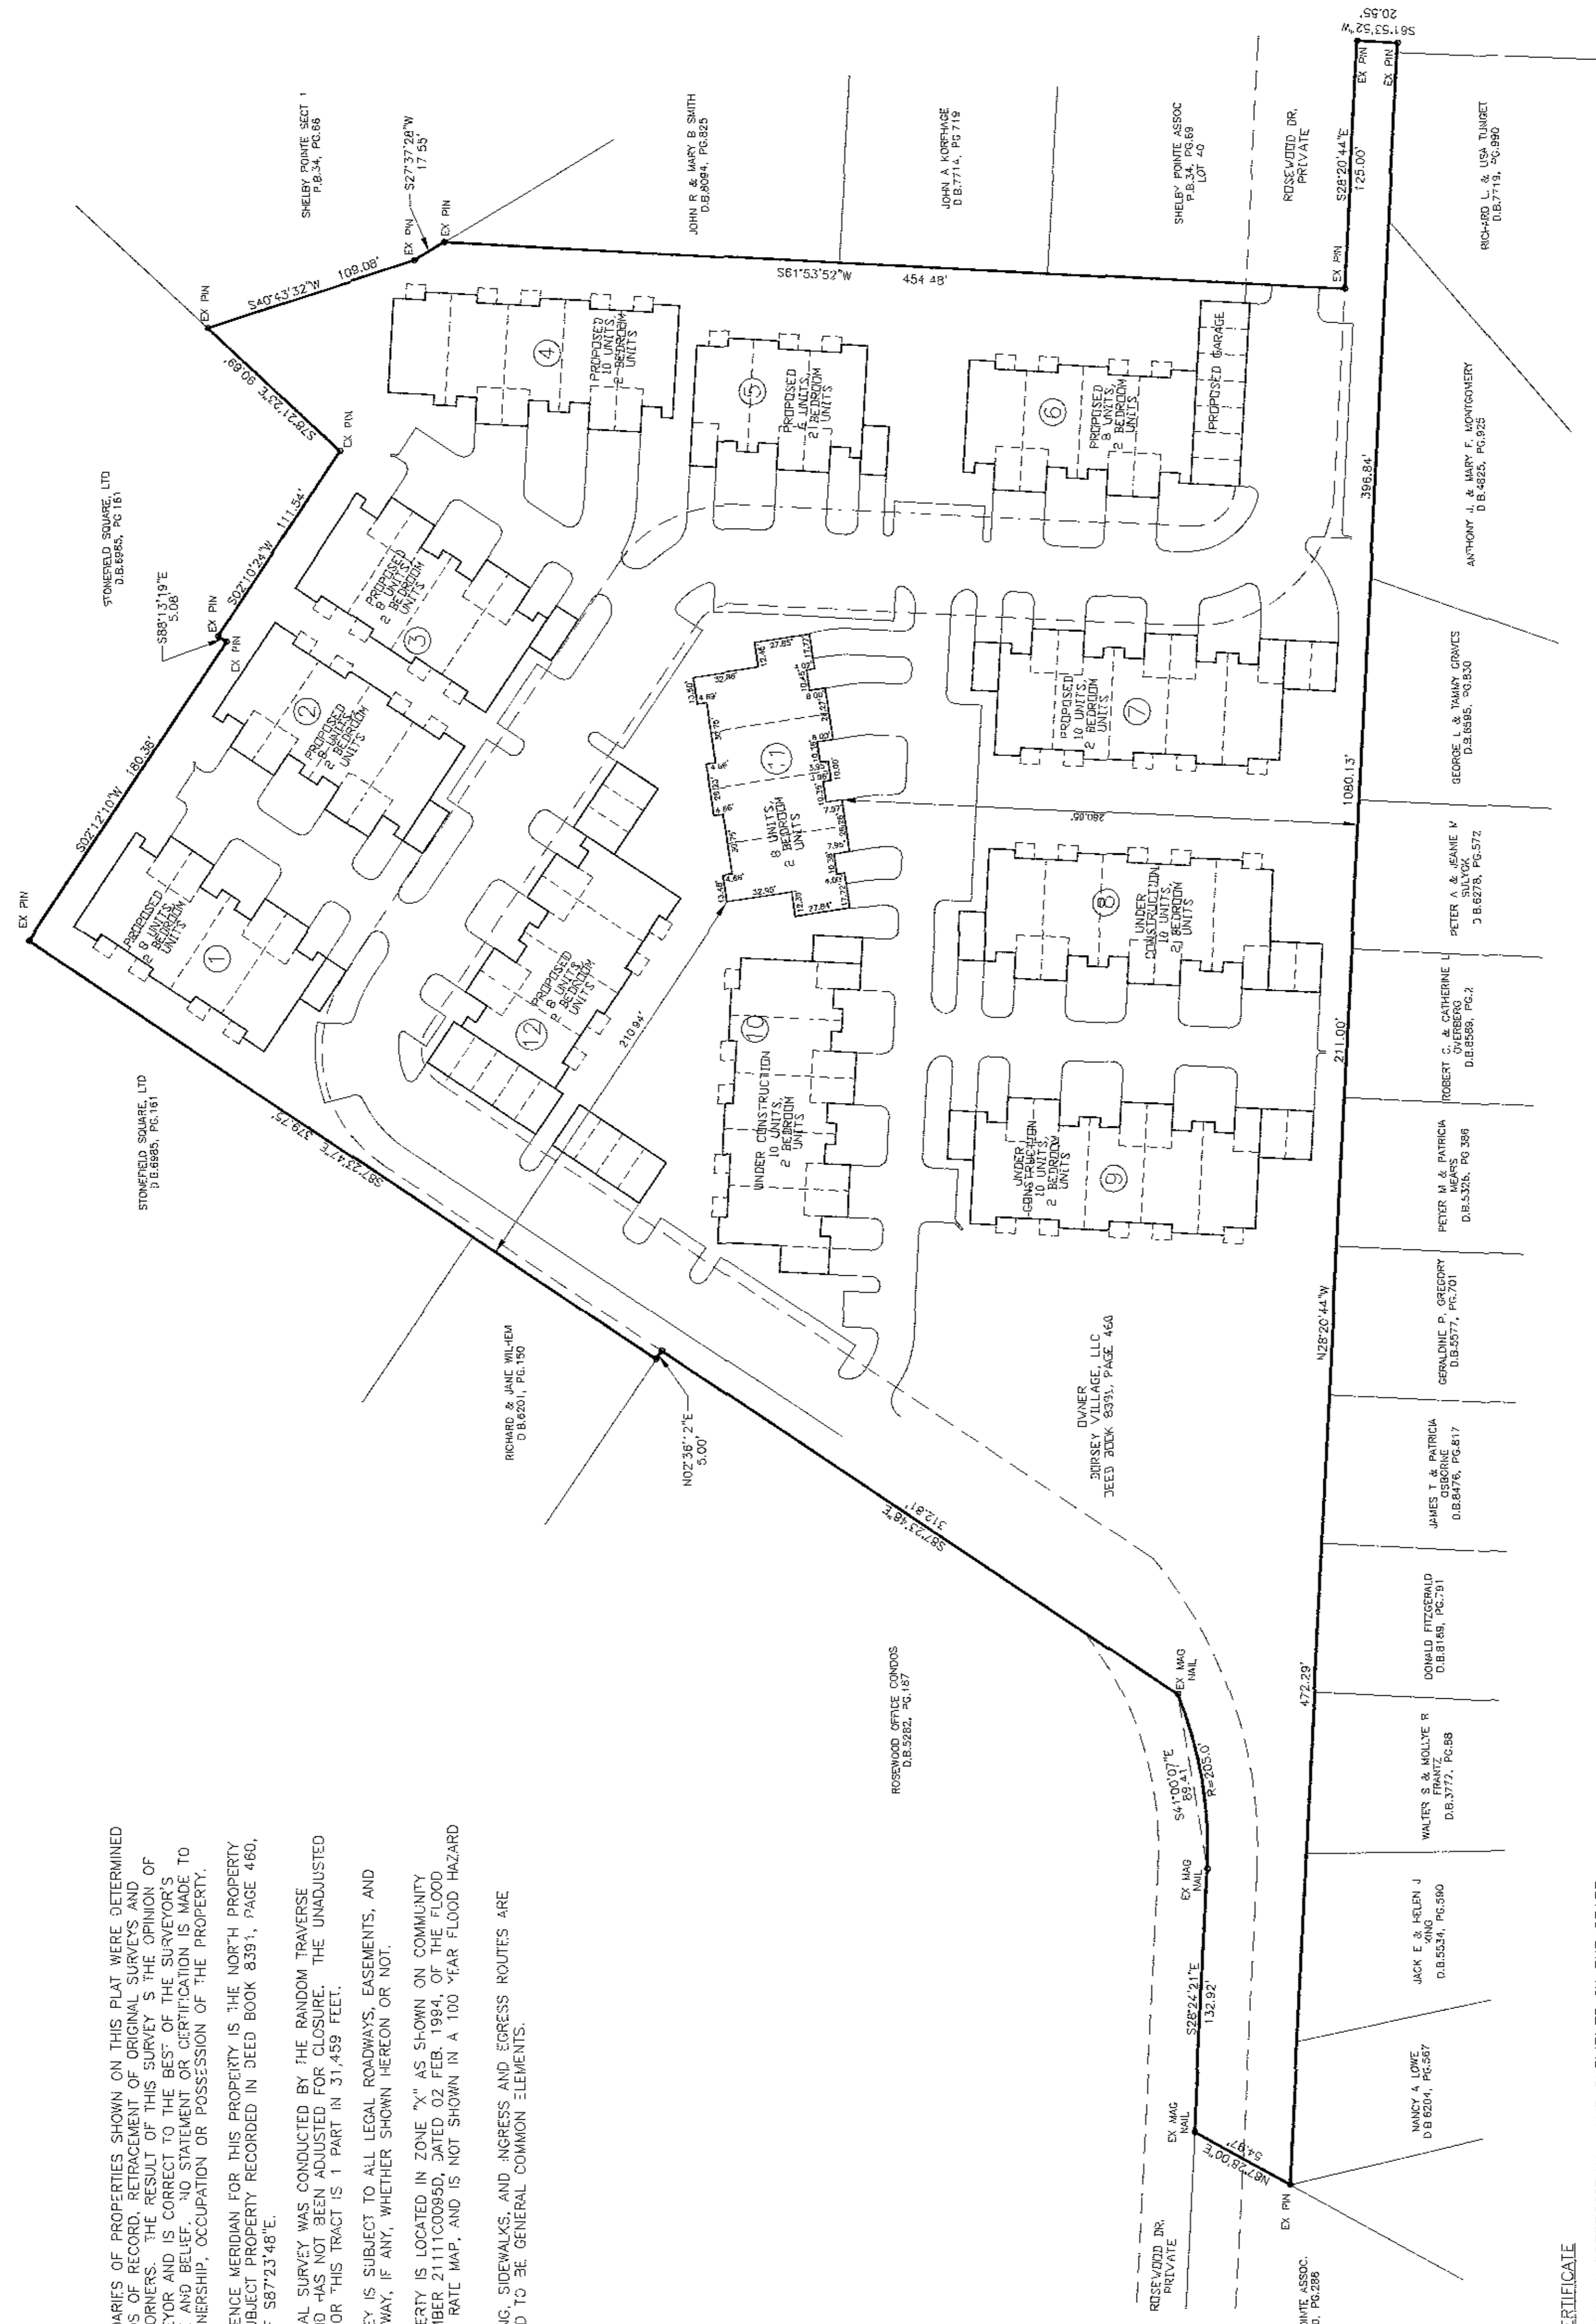

**NOTES**

THE BOUNDARIES OF PROPERTIES SHOWN ON THIS PLAT WERE DETERMINED FROM RECORDS OF RECORD RETRACEMENT OF ORIGINAL SURVEYS AND THIS SURVEYOR'S OPINION IS CORRECT TO THE BEST OF HIS KNOWLEDGE AND BELIEF. NO STATEMENT OR CERTIFICATION IS MADE TO ACTUAL OWNERSHIP, OCCUPATION OR POSSESSION OF THE PROPERTY.

THE REFERENCE MERIDIAN FOR THIS PROPERTY IS THE NORTH PROPERTY LINE OF SUBJECT PROPERTY RECORDED IN DEED BOOK 8391, PAGE 460, BEARING OF S87°23'48"E.

THE ORIGINAL SURVEY WAS CONDUCTED BY THE RANDOM TRAVERSE METHOD AND HAS NOT BEEN ADJUSTED FOR CLOSURE. THE UNADJUSTED CLOSURE FOR THIS TRACT IS 1 PART IN 31,459 FEET.

THIS SURVEY IS SUBJECT TO ALL LEGAL ROADWAYS, EASEMENTS, AND RIGHT-OF-WAY, IF ANY, WHETHER SHOWN HEREON OR NOT.

THIS PROPERTY IS LOCATED IN ZONE "X" AS SHOWN ON COMMUNITY PANEL NUMBER 21111C0095D, DATED 02 FEB. 1984, OF THE FLOOD INSURANCE RATE MAP, AND IS NOT SHOWN IN A 100 YEAR FLOOD HAZARD AREA.

ALL PARKING, SIDEWALKS, AND INGRESS AND EGRESS ROUTES ARE CONSIDERED TO BE GENERAL COMMON ELEMENTS.


STATE OF KENTUCKY  
JAMES F. CREAN  
3139  
LICENSED  
PROFESSIONAL  
LAND SURVEYOR

**SURVEYOR'S CERTIFICATE**

I, JAMES F. CREAN, A PROFESSIONAL LAND SURVEYOR IN THE STATE OF KENTUCKY, HAVE CONDUCTED A SURVEY OF THE HORIZONTAL AND VERTICAL MEASUREMENTS OF THE CONDOMINIUM UNITS AND IMPROVEMENTS FULLY AND ACCURATELY DEPICT THE LAYOUT, LOCATION, UNIT NUMBERS, AND DIMENSIONS OF THE UNITS AS BUILT AS REQUIRED BY KRS 381.83, AMENDED 1998 KY ACTS CH. 214, SEC 4.

*James F. Crean*  
3139  
Date  
3-29-05  
PLS#  
SIGNATURE

**LOT IS SUBJECT...**  
THIS PLAT IS SUBJECT TO ALL DEFECTS, LIENS, ENCUMBRANCES, ADVERSE CLAIMS, COVENANTS, RESTRICTIONS, ALL LEGAL EASEMENTS, RIGHT-OF-WAYS, ETC. WHICH MAY BE REVEALED BY A TITLE SEARCH WHETHER SHOWN ON THIS PLAT OR NOT.

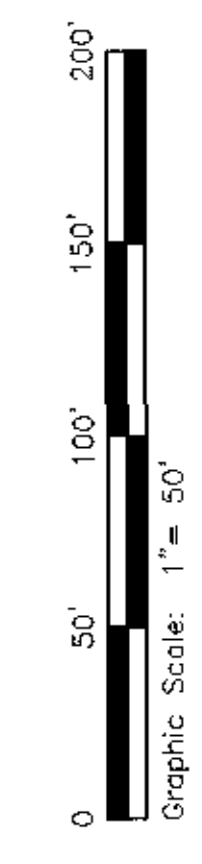

107 x 74

107 x 74