



FLOOR PLAN - BUILDING "2"  
DORSEY VILLAGE CONDOMINIUMS  
DEVELOPER:  
DORSEY VILLAGE LLC  
14407 WILLOW GROVE CIRCLE  
LOUISVILLE, KENTUCKY 40245  
PHONE: (502) 551-0569

**L&D**  
LAND DESIGN & DEVELOPMENT, INC.  
ENGINEERING • LAND SURVEYING • LANDSCAPE ARCHITECTURE  
204 WESTFIRST AVENUE • LOUISVILLE, KENTUCKY 40202  
PHONE: (502) 551-9714 FAX: (502) 551-9715



PROJECT DATA  
FILE NAME: BUILDING2.dwg  
SCALE: 1/8"=1'-0"  
DATE: FEB. 21, 2006  
CHECKED BY: POP  
DRAWN BY: POP

ENGINEER'S SEAL  
SURVEYOR'S SEAL

NO.	DATE	DESCRIPTION	BY

Recorded in Caddo Book  
No. 114 Page 4  
Part No. 200  
6939403102

Engineer: Mark L. Winters, P.E.  
Professional Seal No. 88866/7933  
Professional Seal State: KY  
Local Firm: L&D  
Address: 204 Westfirst Ave., Louisville, KY 40202  
County: Jefferson  
Company: L&D  
Project: Dorsey Village  
Drawing: 03139  
Scale: 1/8"=1'-0"  
Date: 2/21/06

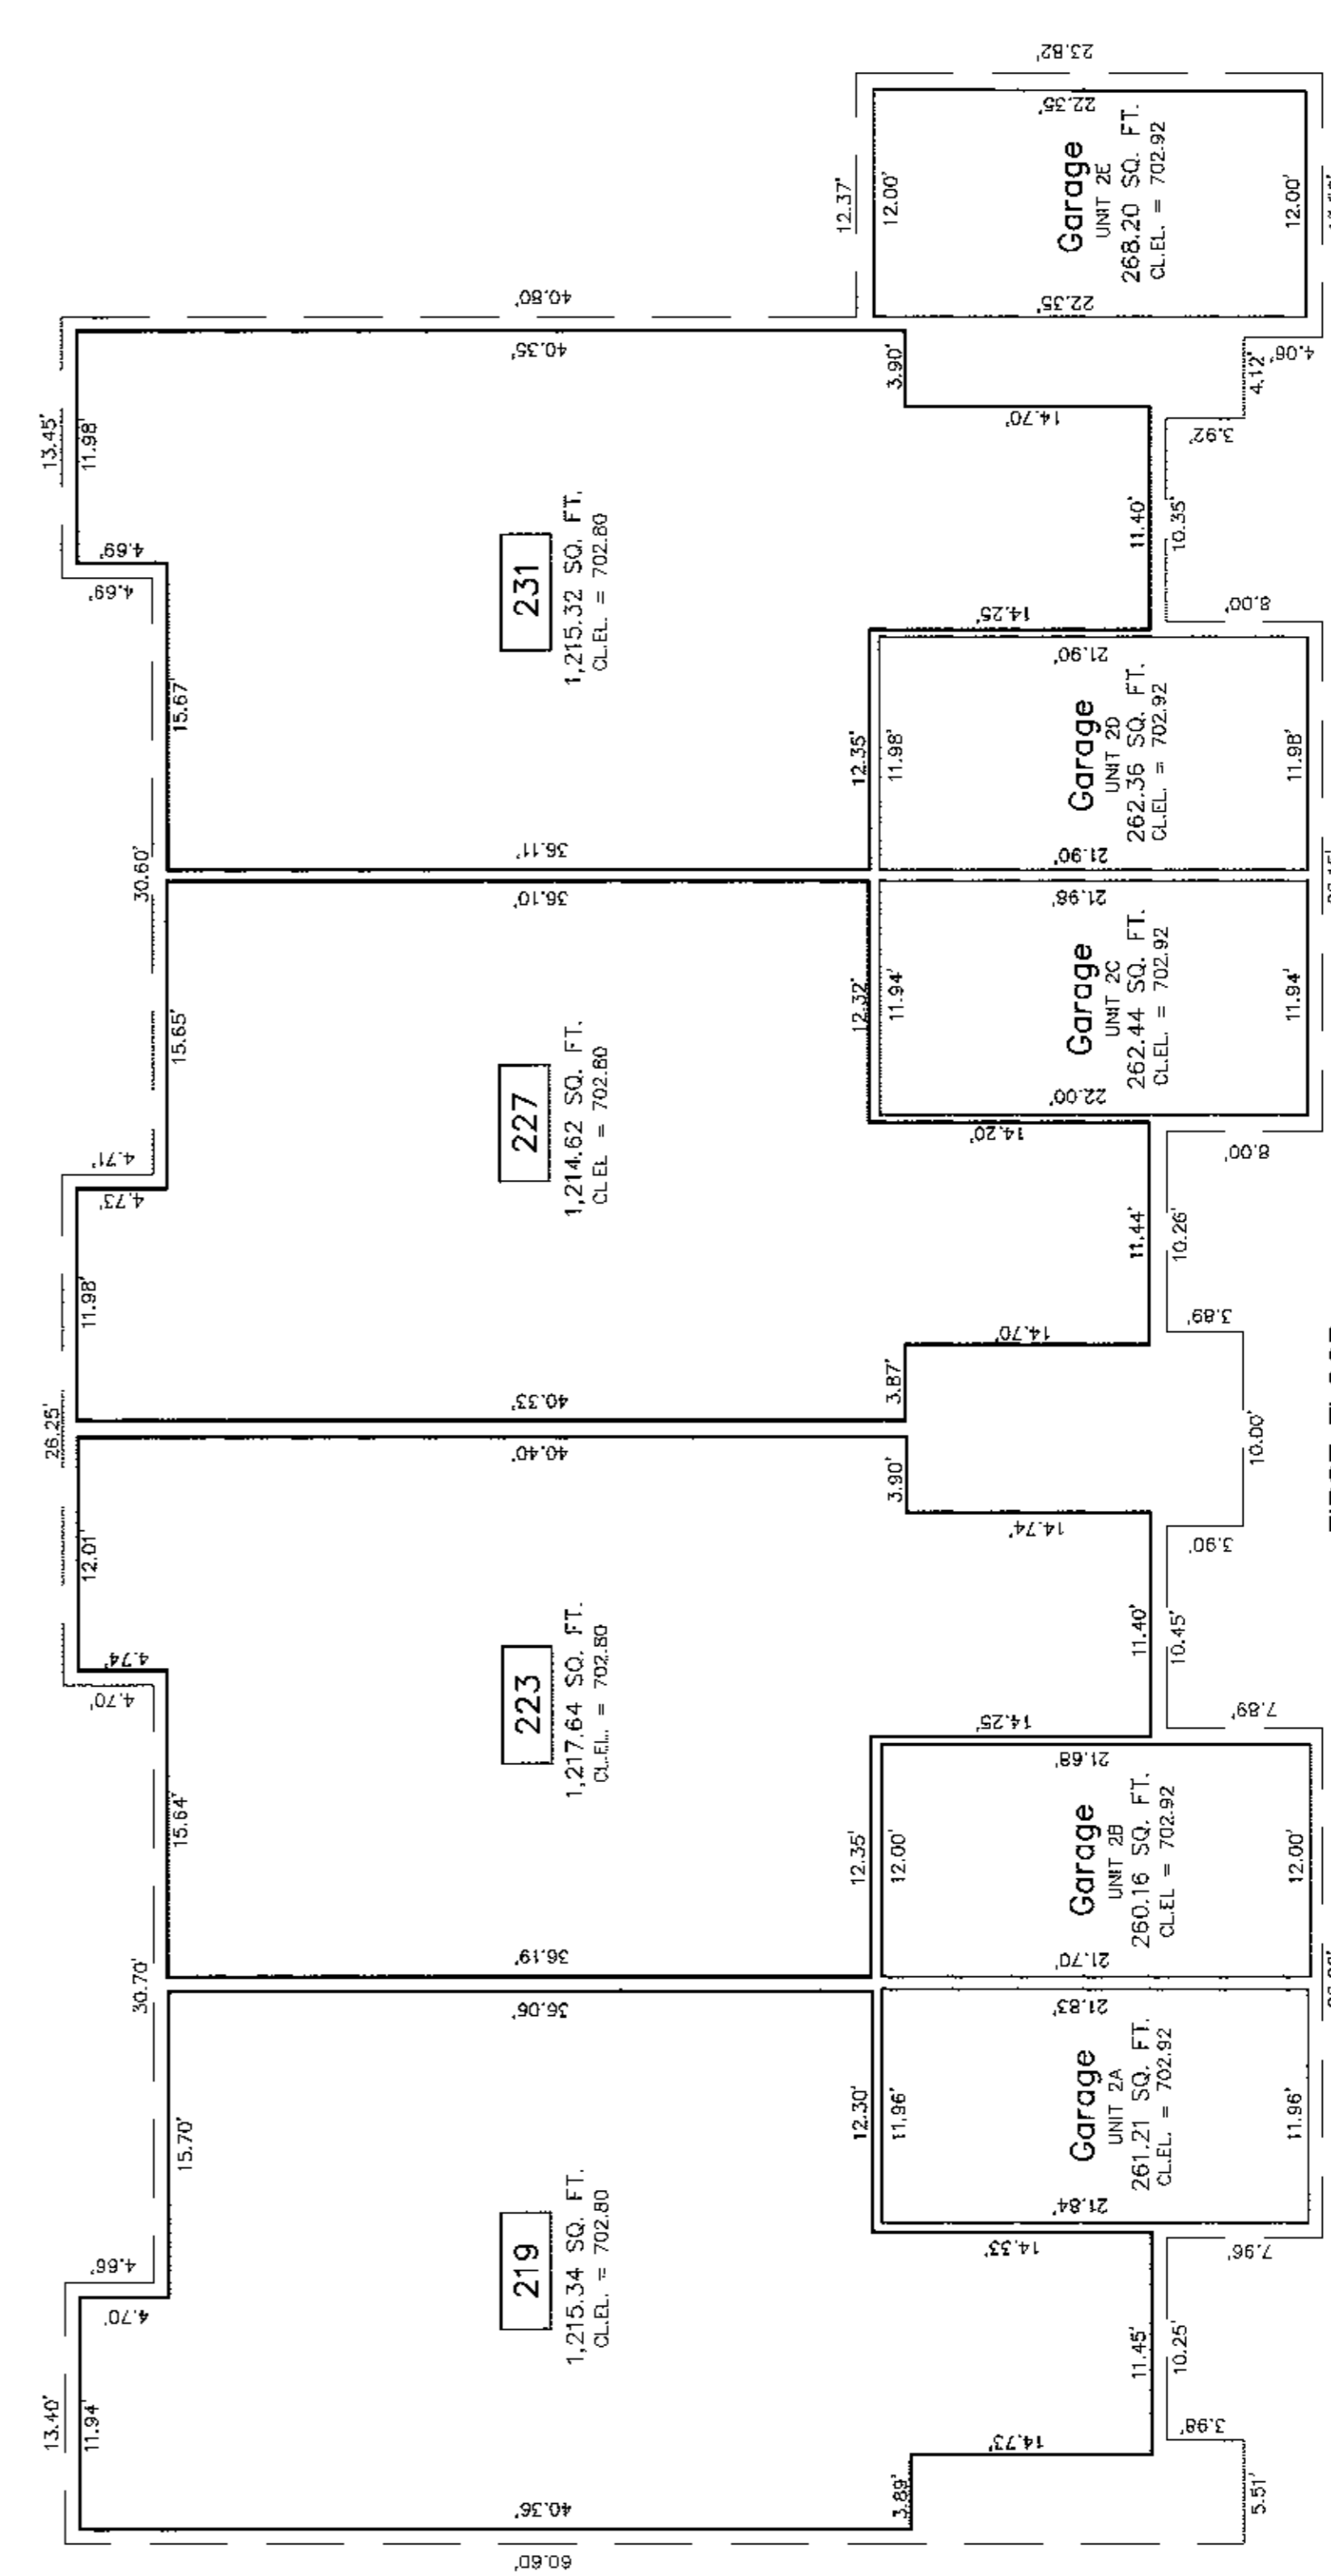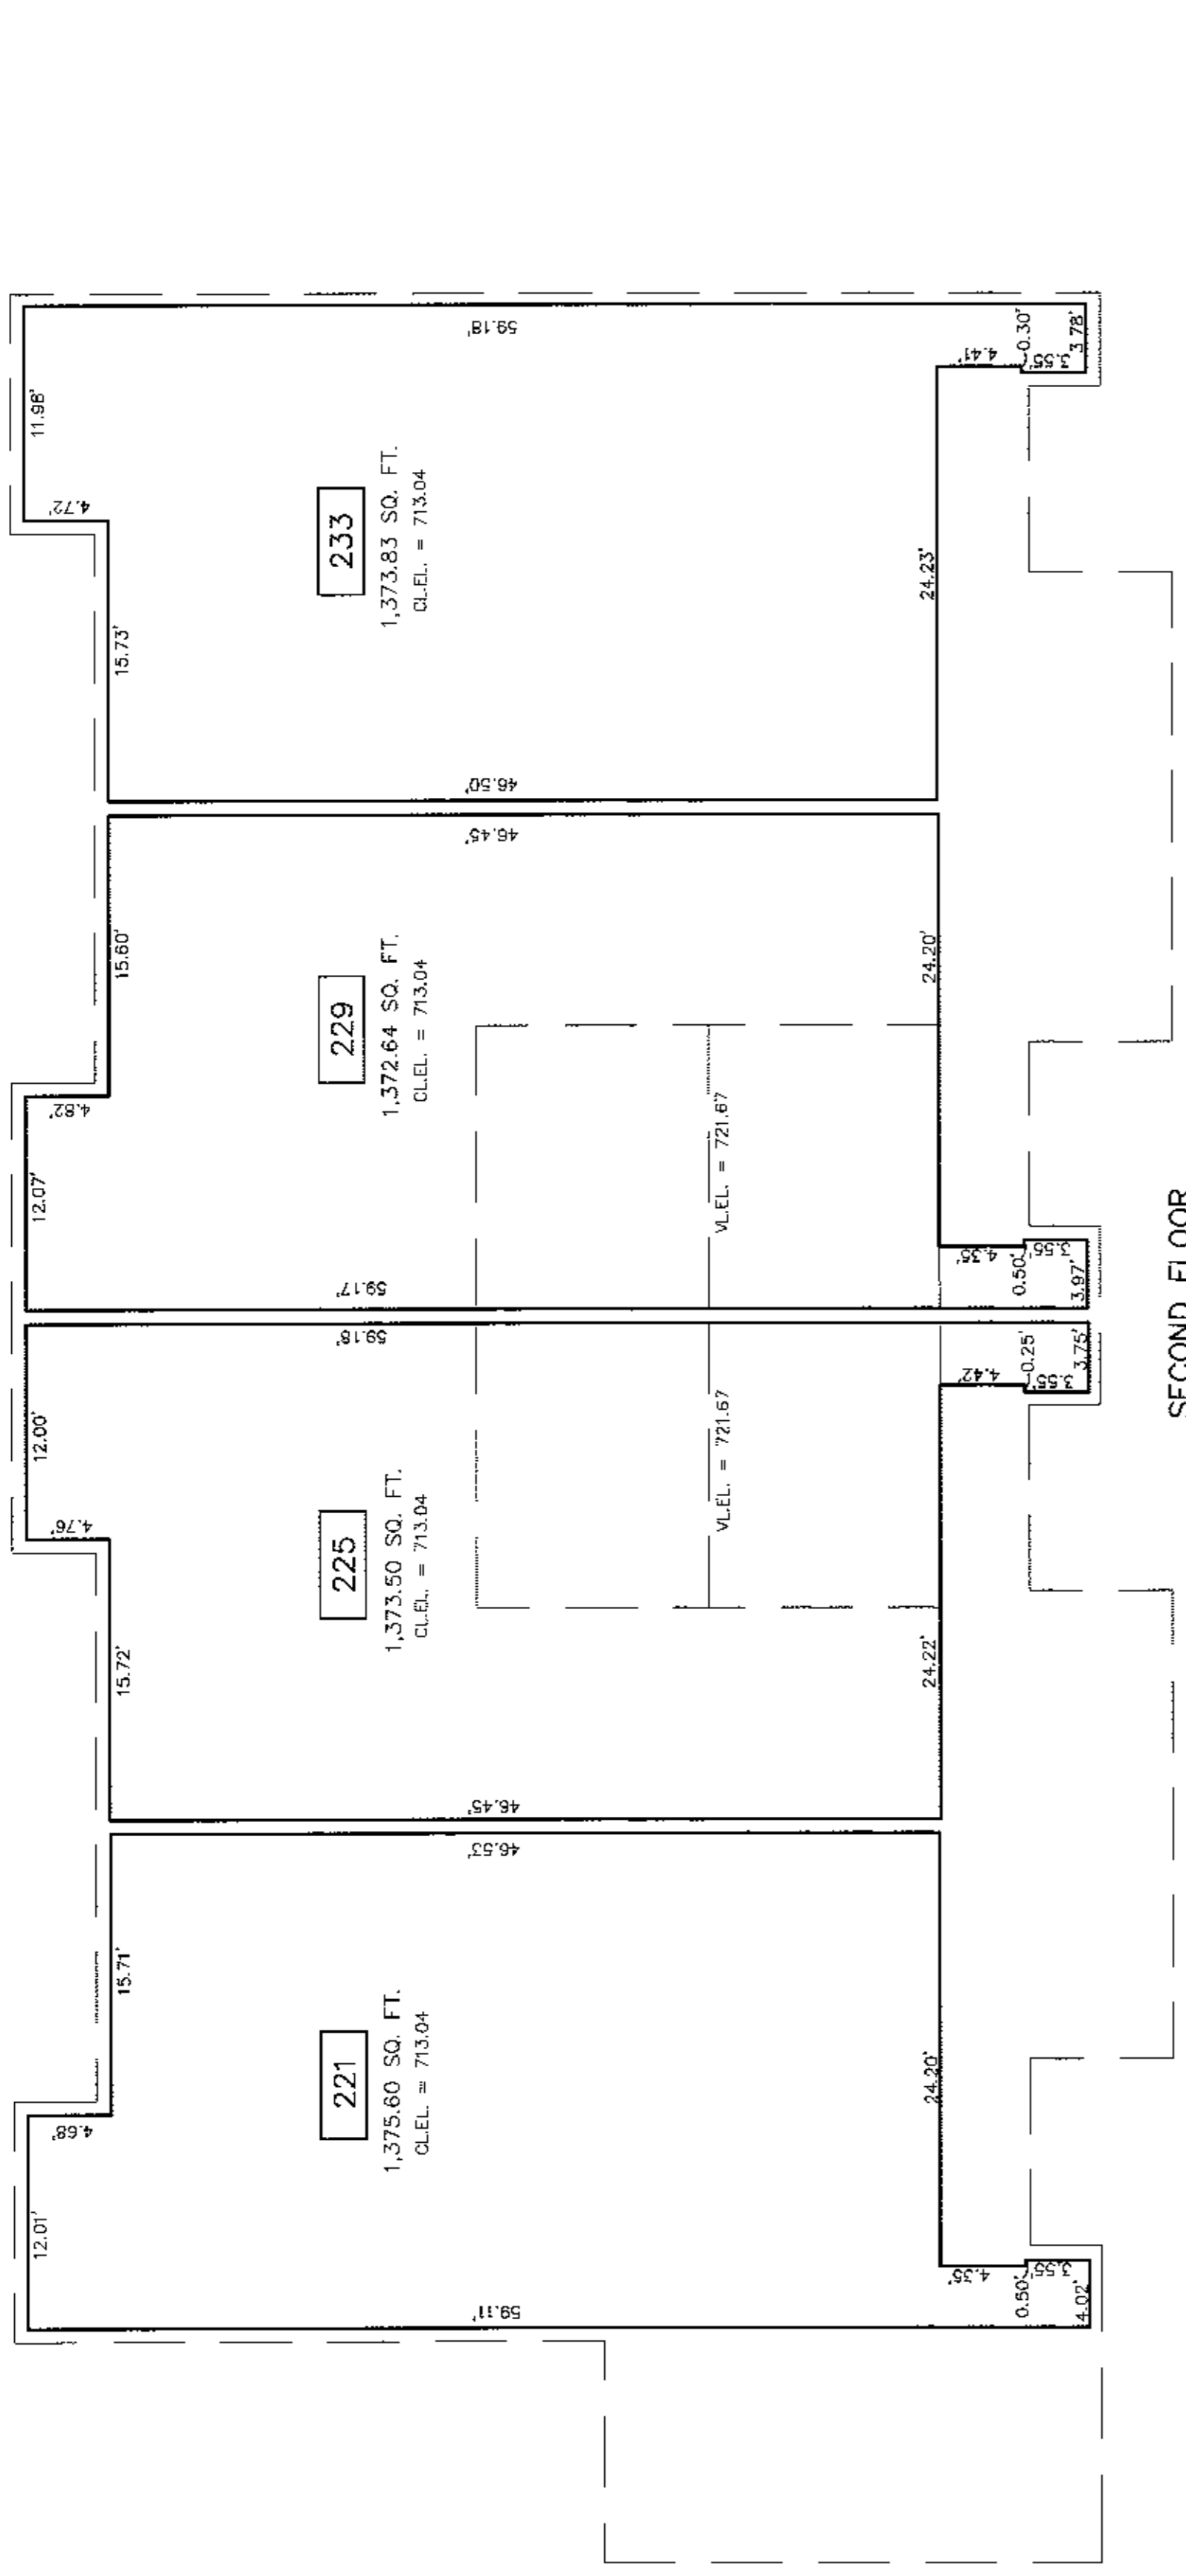

**LEGEND**  
 - UNIT NUMBER  
 - CEILING ELEVATION  
 - LIMITS OF OWNERSHIP  
 - LIMITS OF COMMON SPACE (BUILDING EXTERIOR)

114x11

114x11

114x11

SITE PLAN - BUILDING '12' & GARAGE UNITS '5-10'  
DORSEY VILLAGE CONDOMINIUMS  
DEVELOPER  
DORSEY VILLAGE LLC  
1407 WILLOW GROVE CIRCLE  
LOUISVILLE, KENTUCKY 40245  
PHONE: (502) 551-0569

**L&D**  
LAND DESIGN & DEVELOPMENT, INC.  
ENGINEERING, LAND SURVEYING, LANDSCAPE ARCHITECTURE  
1000 W. MARKET STREET, SUITE 100, LOUISVILLE, KENTUCKY 40202  
PHONE: 502-416-0714 FAX: 502-416-2725

PROJECT DATA  
FILE NAME: 03139.CONDOMINIUMS  
DATE: OCT. 26, 2005  
SCALE: 1"=40'  
CHECKED BY: PJP  
DRAWN BY: PJP


ENGINEER'S SEAL  
SURVEYOR'S SEAL

NO.	DATE	DESCRIPTION	BY



**ENGINEER'S CERTIFICATE**  
I HEREBY CERTIFY THAT THIS IS A TRUE AND ACCURATE COPY OF THE DRAWINGS AND PLANS OF BUILDING '12' & GARAGE UNITS 5-10, A CONDOMINIUM PROJECT SHOWING THE LAYOUT, LOCATION AND DIMENSIONS OF THE UNITS AS BUILT.  
DATE: 10-28-05  
Scott A. Spaw  
LICENSED PROFESSIONAL ENGINEER

**SURVEYOR'S CERTIFICATE**  
I HEREBY CERTIFY THAT THE SURVEY FOR THIS PLAT FOR BUILDINGS WAS MADE UNDER MY SUPERVISION AND THAT THE MEASUREMENTS WERE MADE BY ME OR BY A LICENSED SURVEYOR UNDER MY CLOSE PERSONAL SUPERVISION AND THE FIELD AND ARE TRUE AND CORRECT TO THE BEST OF MY KNOWLEDGE AND BELIEF AND TO THE BEST OF MY KNOWLEDGE AND BELIEF THE MINIMUM STANDARDS OF GOVERNING AUTHORITIES.  
DATE: 10-28-05  
David W. Winkler  
LICENSED PROFESSIONAL SURVEYOR

**LEGEND**  
⑫ - BUILDING NUMBER  
G-5 - GARAGE "UNIT NUMBER"

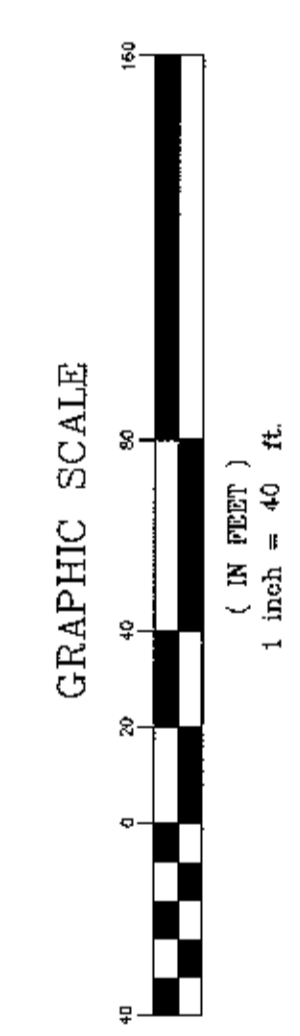

- GENERAL NOTES:**
- 1) SEE SHEET 2 FOR OVERALL DIMENSIONS OF BUILDING 12 & GARAGE UNITS 5-10.
  - 2) ALL INTERIOR ANGLES OF CONDOMINIUMS ARE 90 DEGREES OR AS SHOWN.
  - 3) EACH CONDOMINIUM UNIT CONSIST OF SPACE BOUNDED BY A VERTICAL PROJECTION OF THE CONDOMINIUM UNIT BOUNDARY LINES AS SHOWN BY THE HORIZONTAL PLANES AT THE FLOOR AND CEILING ELEVATIONS OR AS SHOWN.

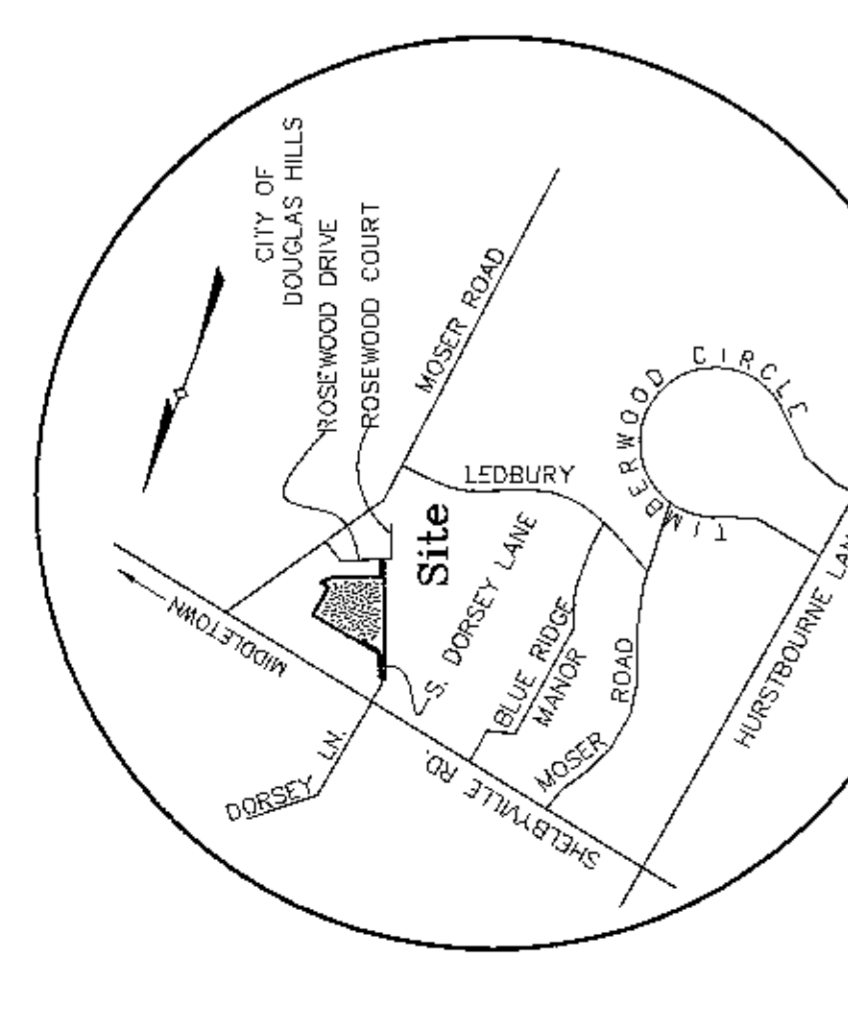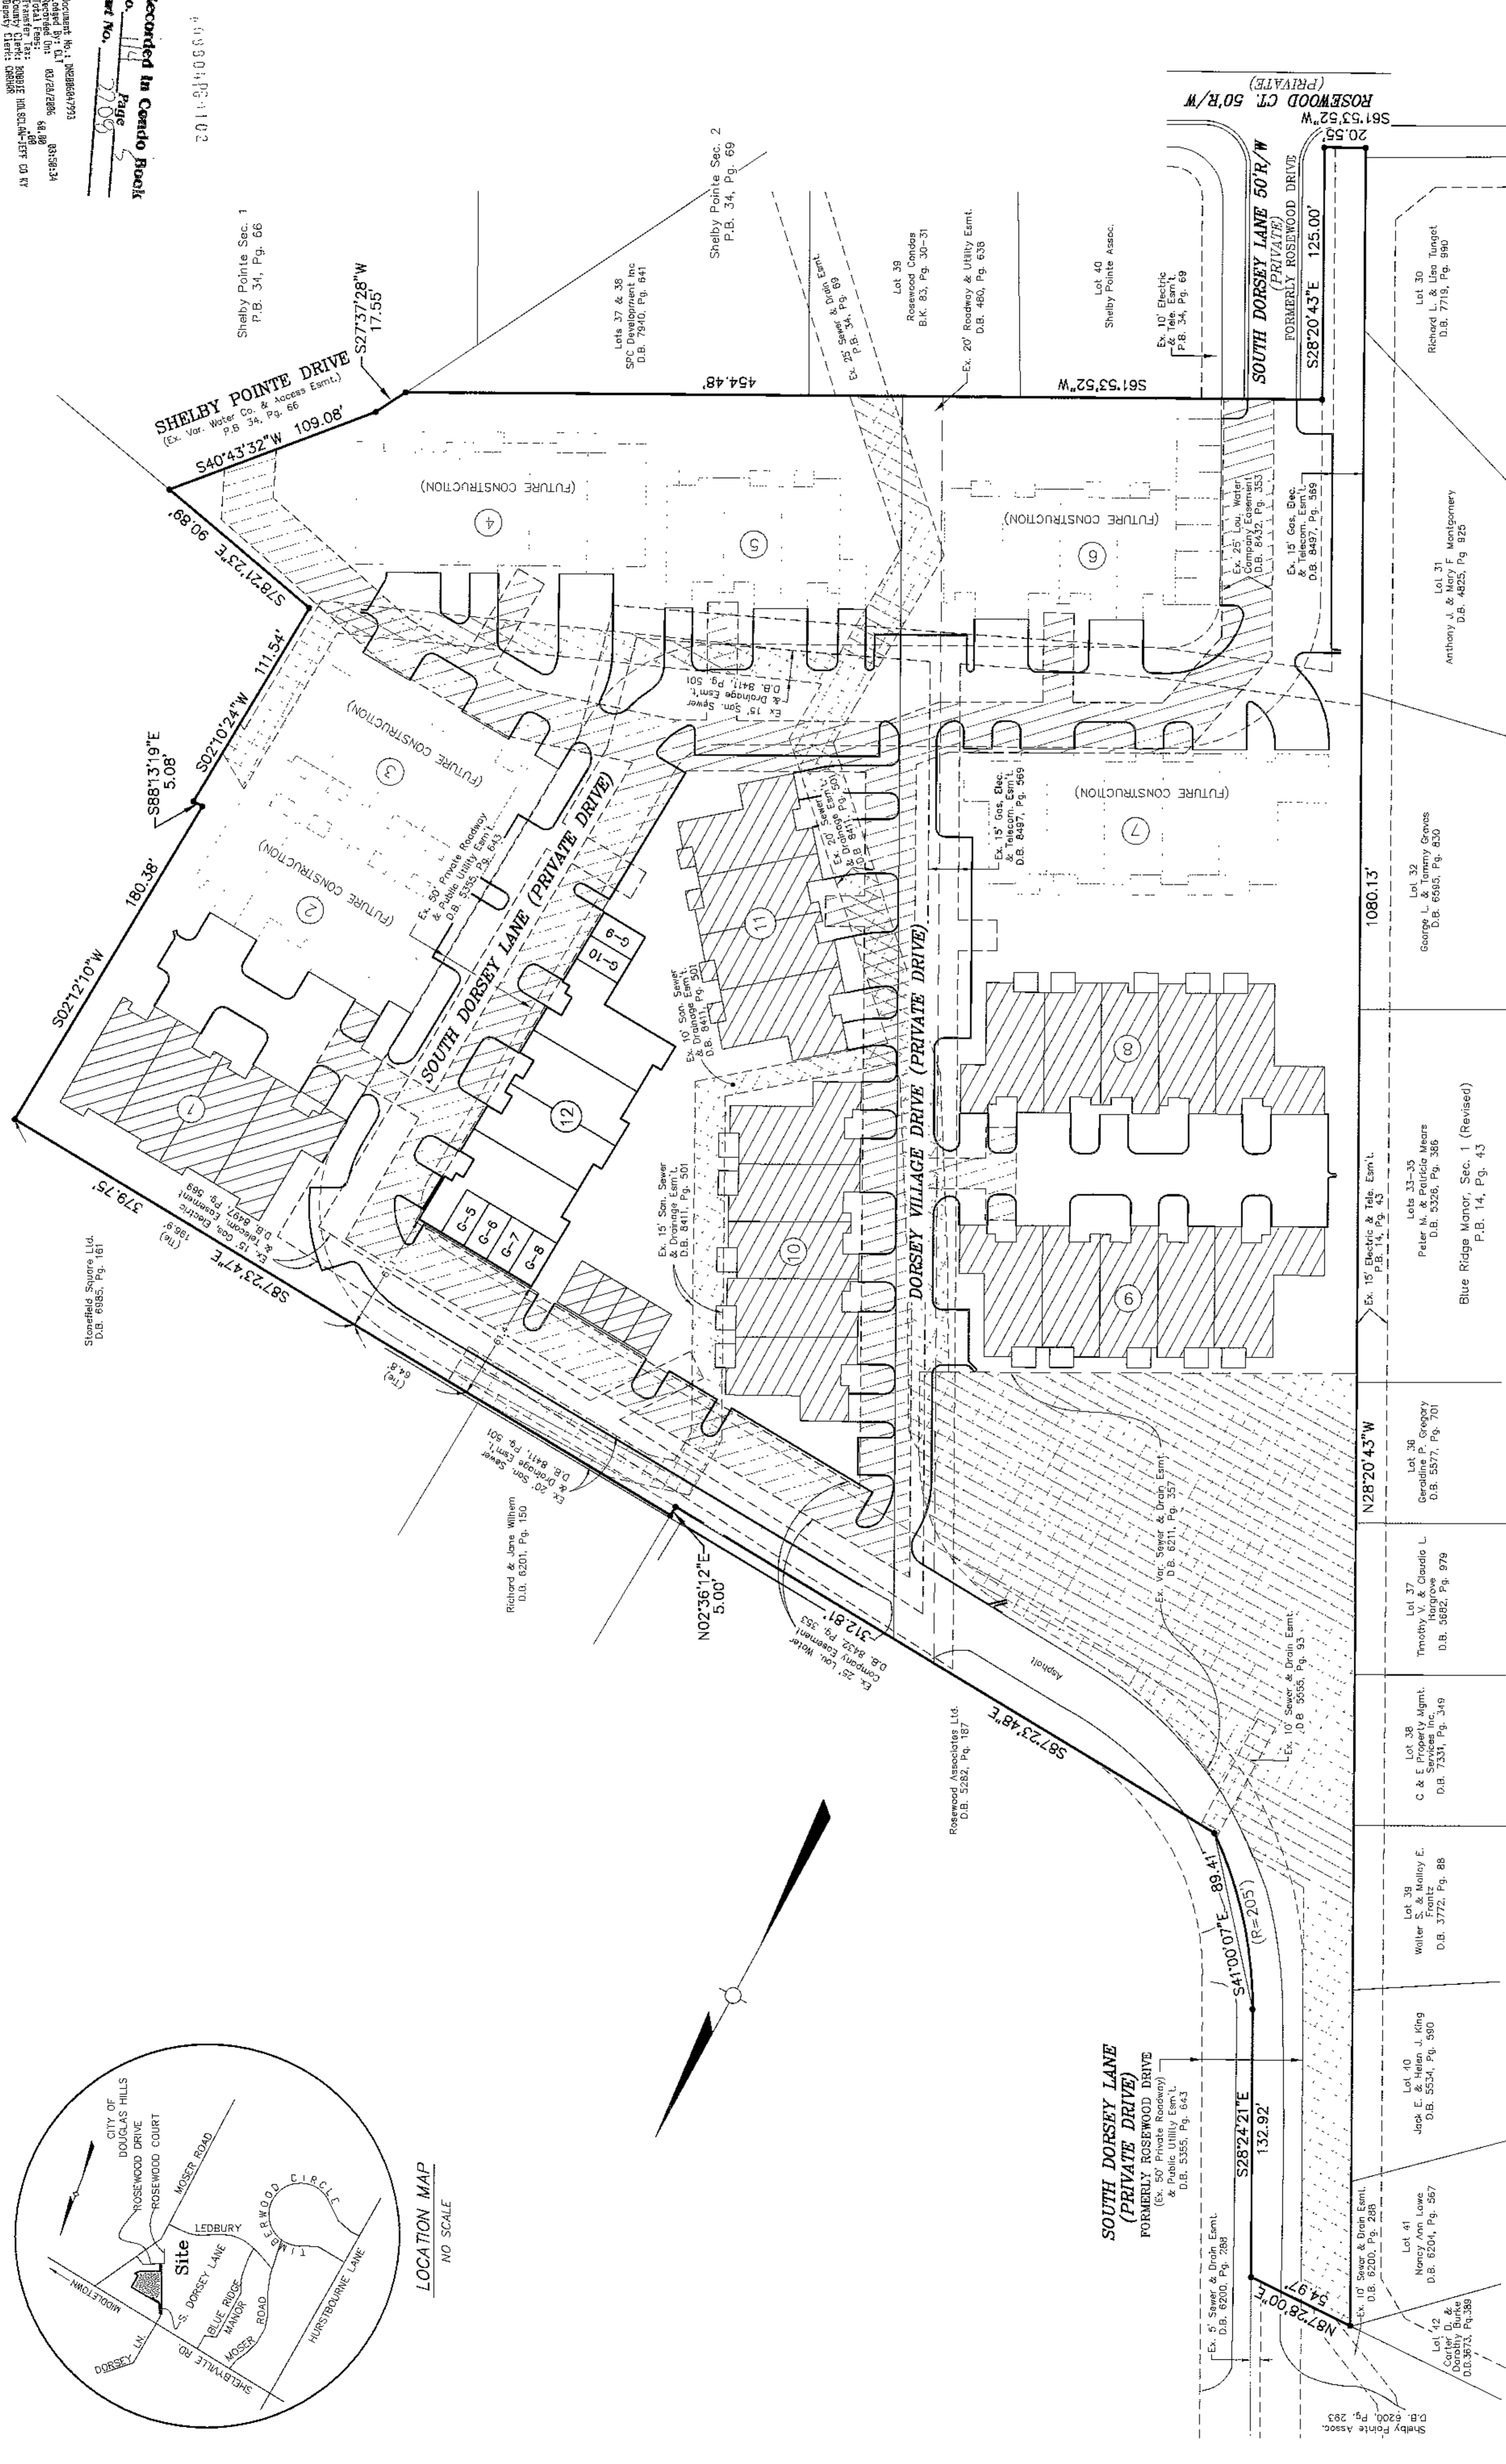

Recorded in Caddo Book  
No. 114 Page 2  
Part No. 2009  
10-28-05

114X5

114X5

114X5

FLOOR PLAN - BUILDING "12" & GARAGE UNITS "5-10"  
DORSEY VILLAGE CONDOMINIUMS  
DEVELOPER:  
DORSEY VILLAGE LLC  
14407 WILLOW GROVE CIRCLE  
LOUISVILLE, KENTUCKY 40245  
PHONE: (502) 551-0569




**L&D**  
LAND DESIGN & DEVELOPMENT, INC.  
ENGINEERING, LAND SURVEYING, LANDSCAPE ARCHITECTURE  
2014 VANDERBURGH AVENUE, LOUISVILLE, KENTUCKY 40212  
PHONE: 502.442.9714 FAX: 502.442.9715

PROJECT DATA  
 FILE NAME: BUILDING.dwg  
 SCALE: 1"=10'  
 DATE: Oct 28, 2005  
 DRAWN BY: POP  
 CHECKED BY: POP

ENGINEER'S SEAL  
 SURVEYOR'S SEAL

NO.	DATE	DESCRIPTION	BY

Recorded in Certain Book  
 No. 114 Page 100  
 Part No. 200  
 1:029074:3:11102

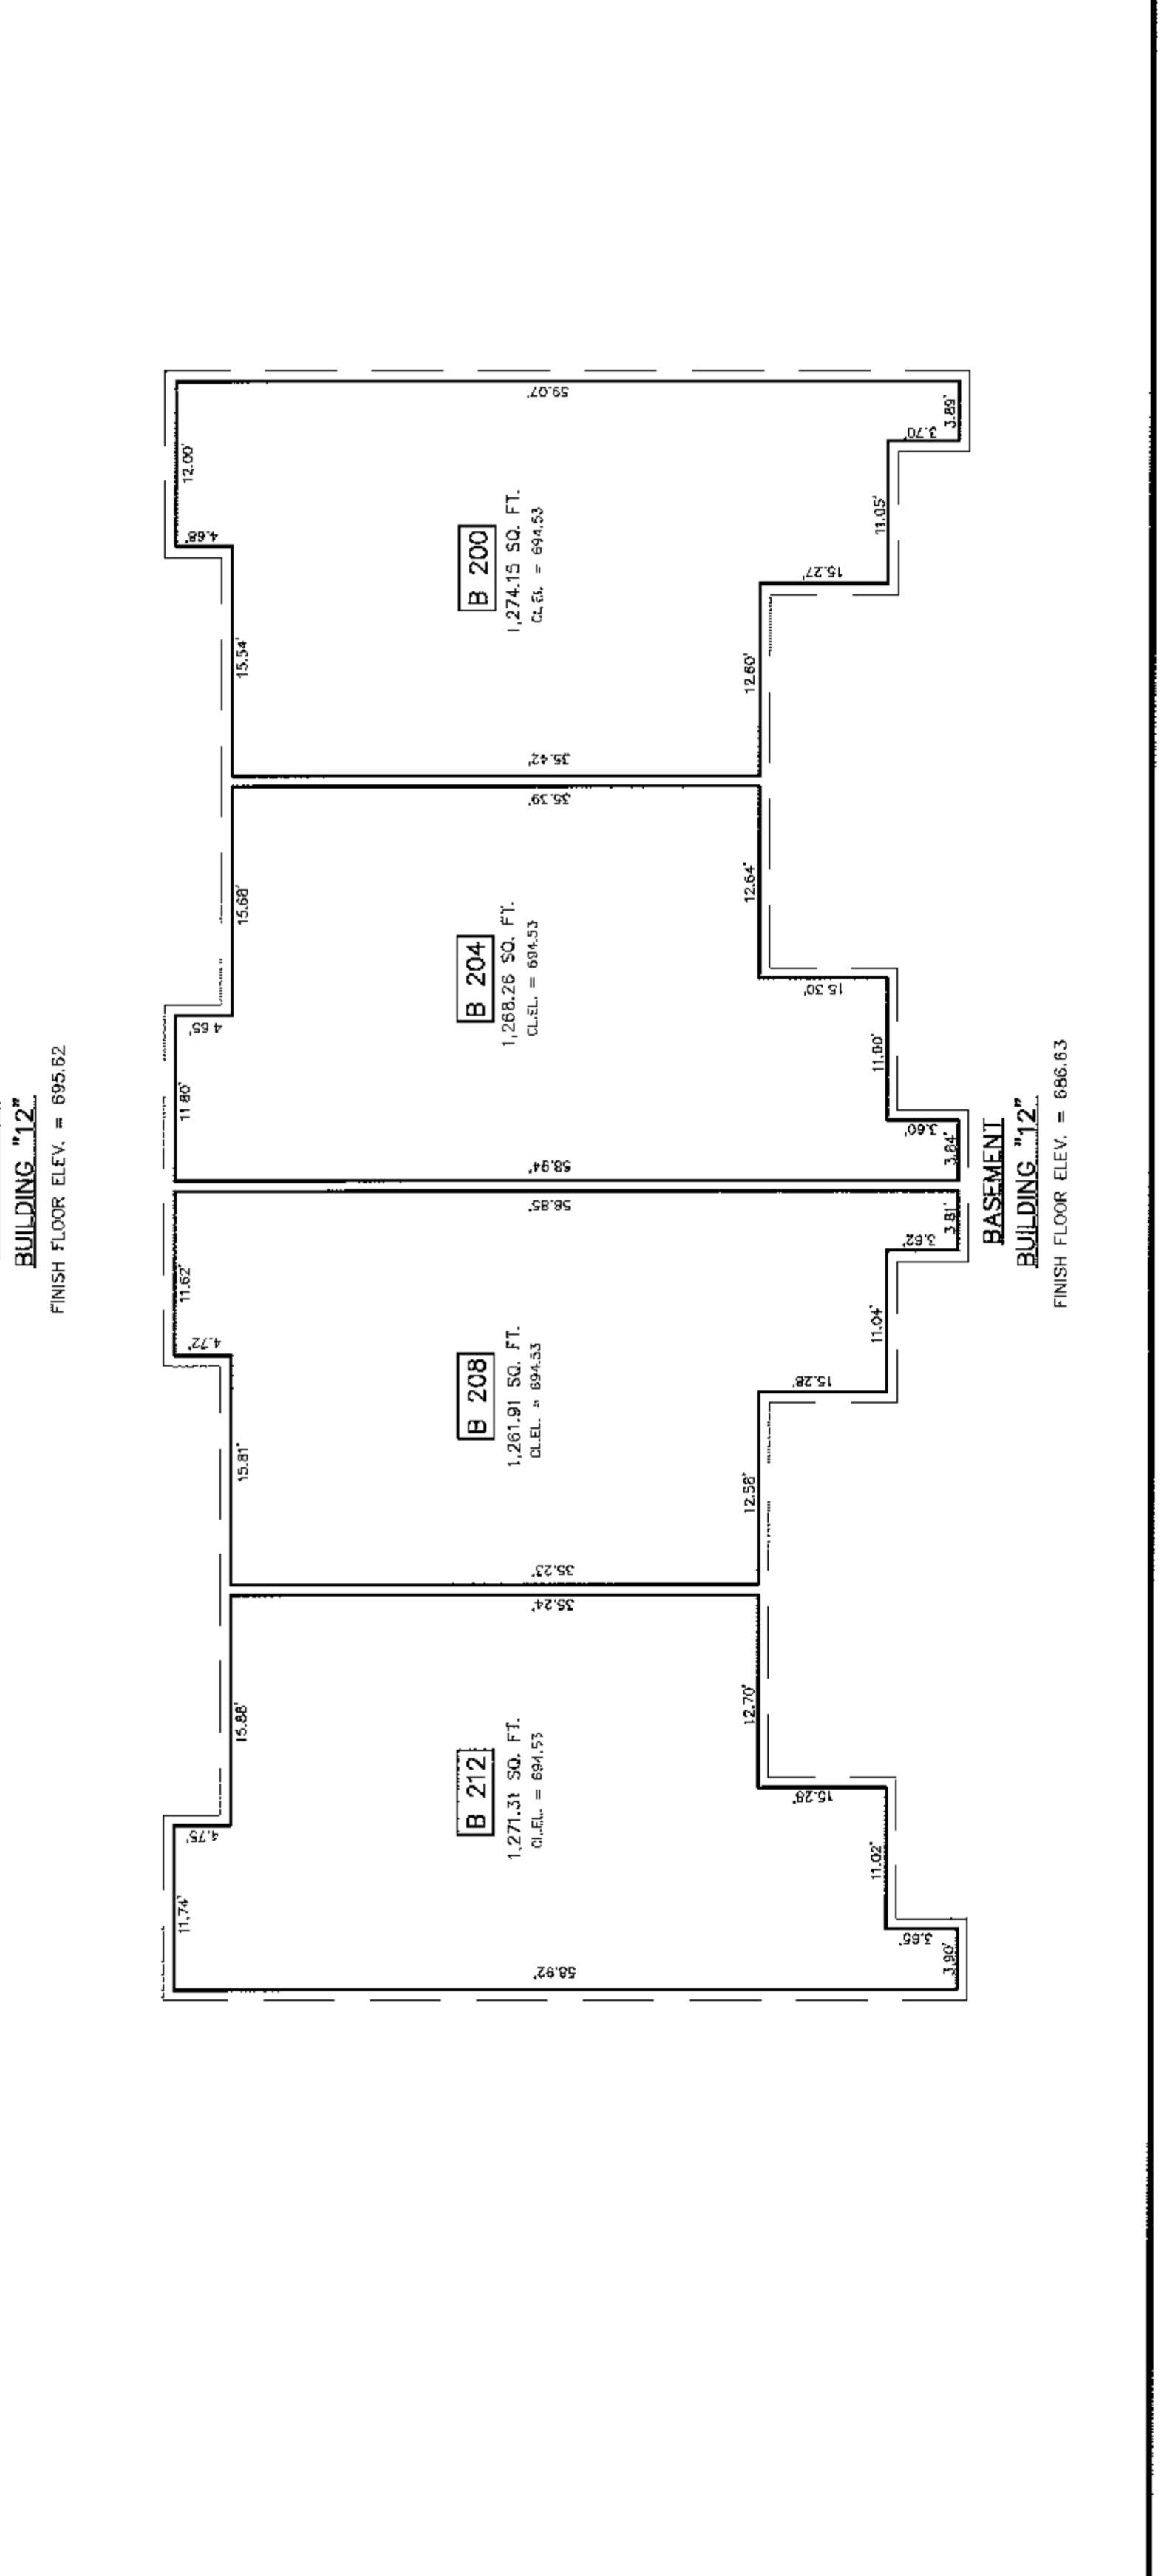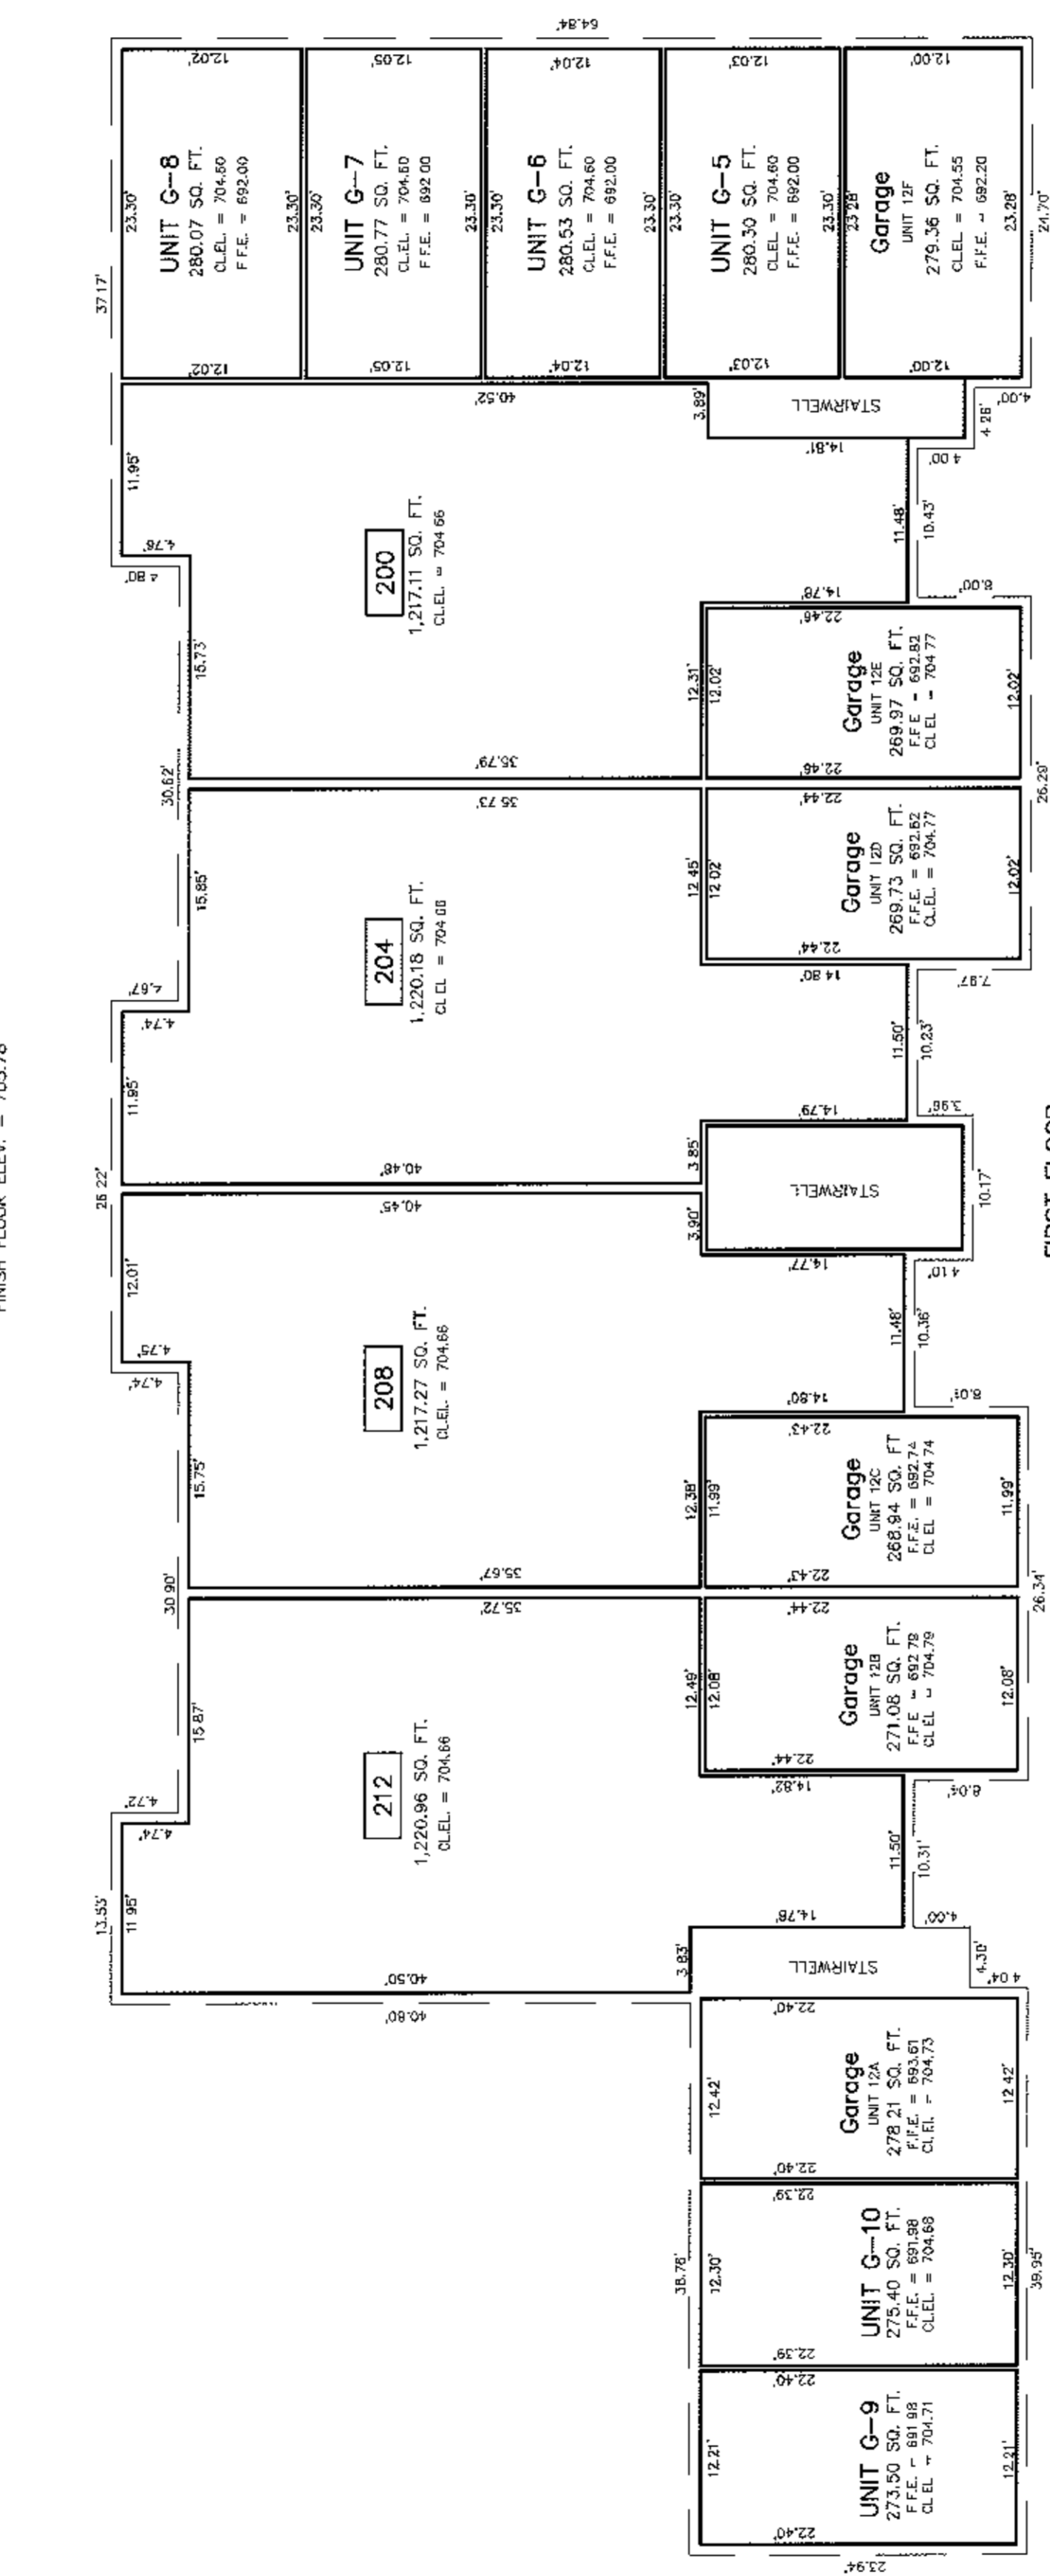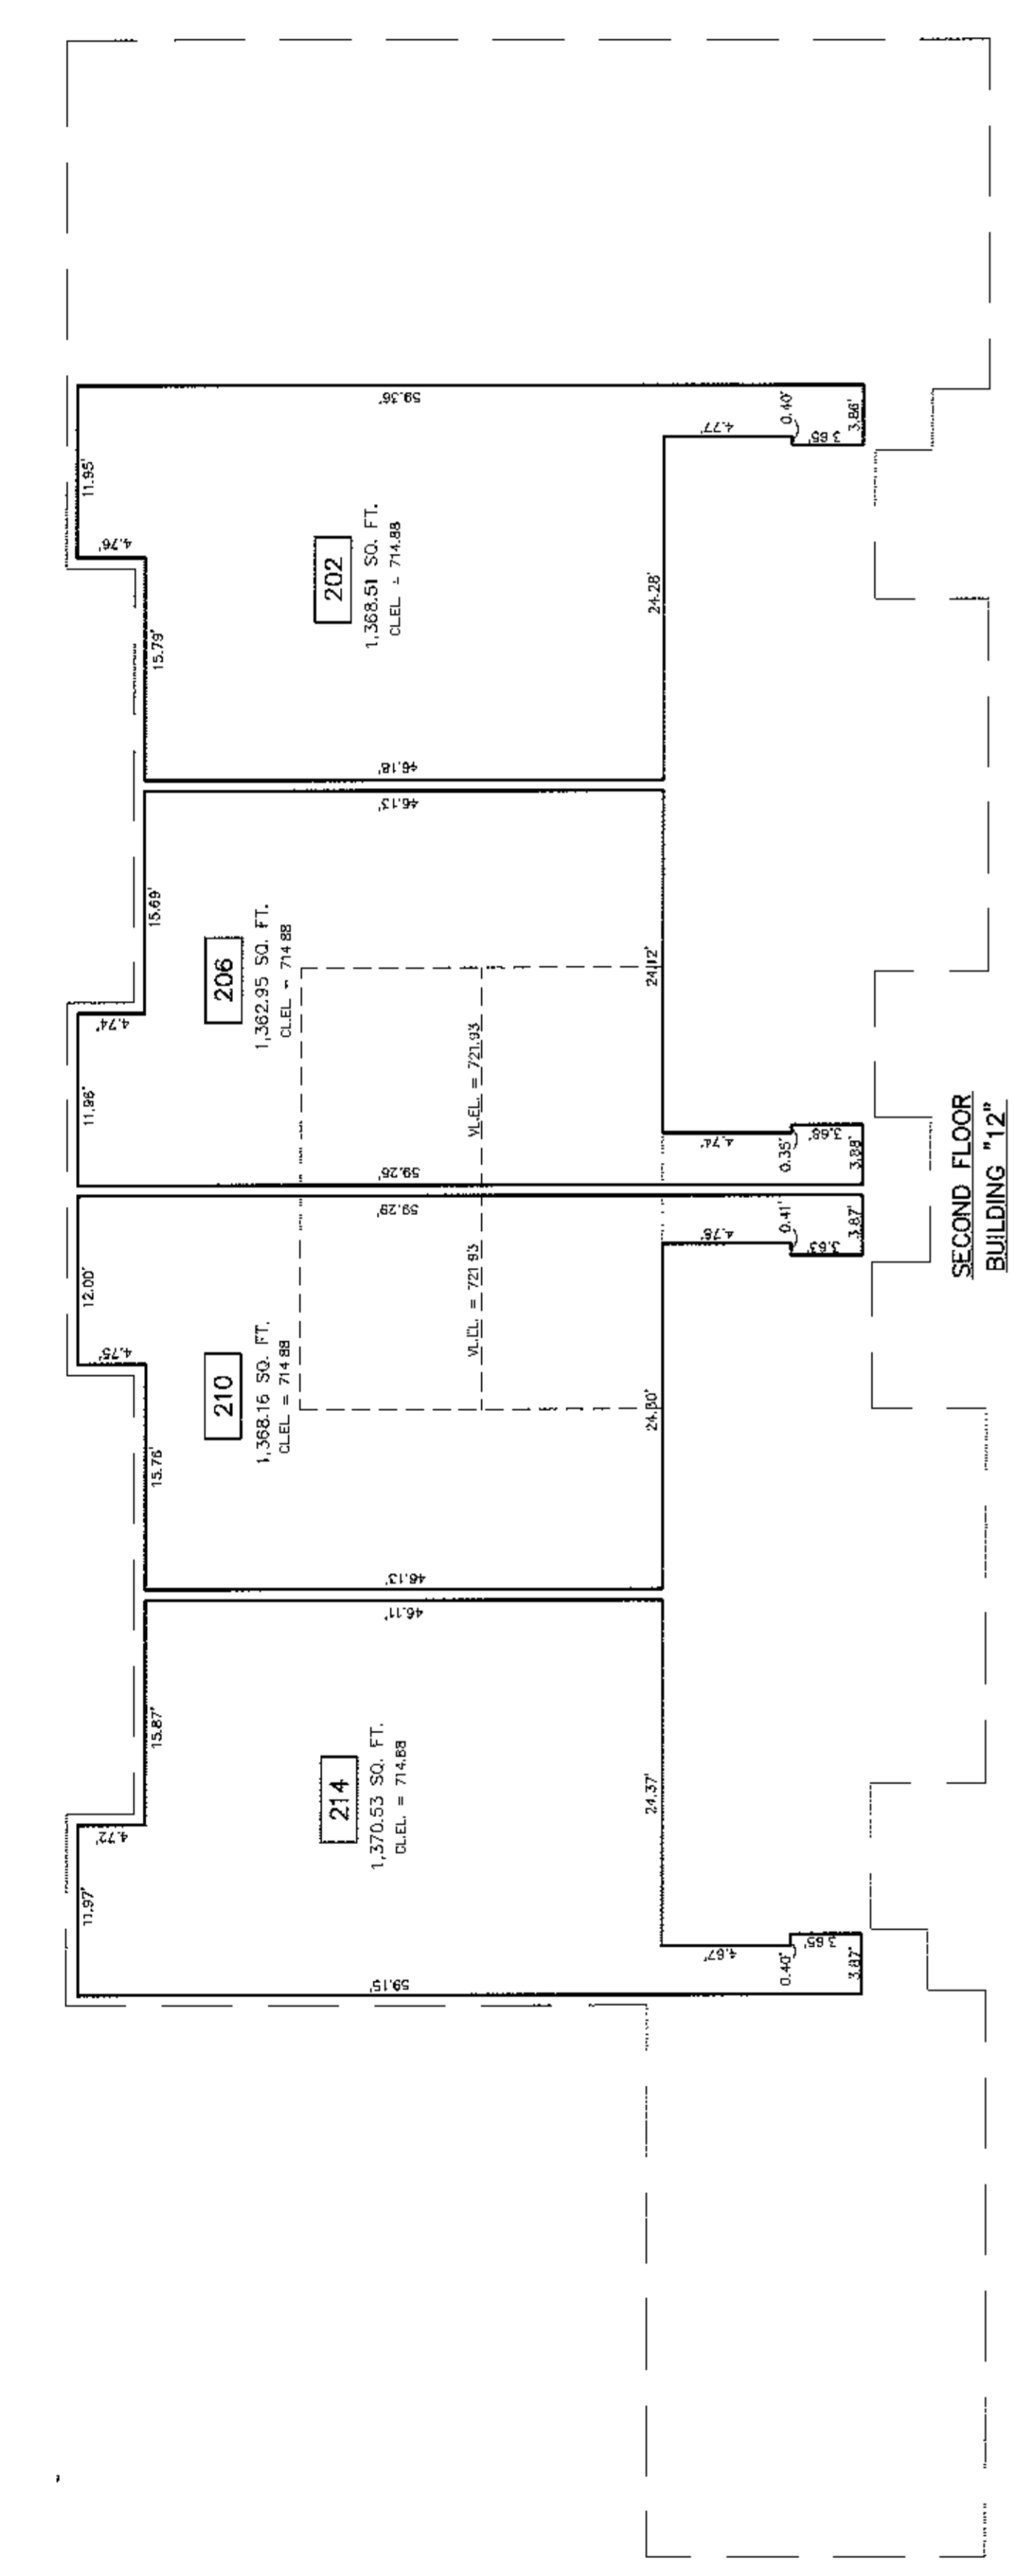

**LEGEND**  
 212 - UNIT NUMBER  
 C.E.L. - CEILING ELEVATION  
 - - - LIMITS OF OWNERSHIP  
 - - - LIMITS OF COMMON SPACE (BUILDING EXTERIOR)

114X10

114X11

114X16