



04 x L11

117 X 40

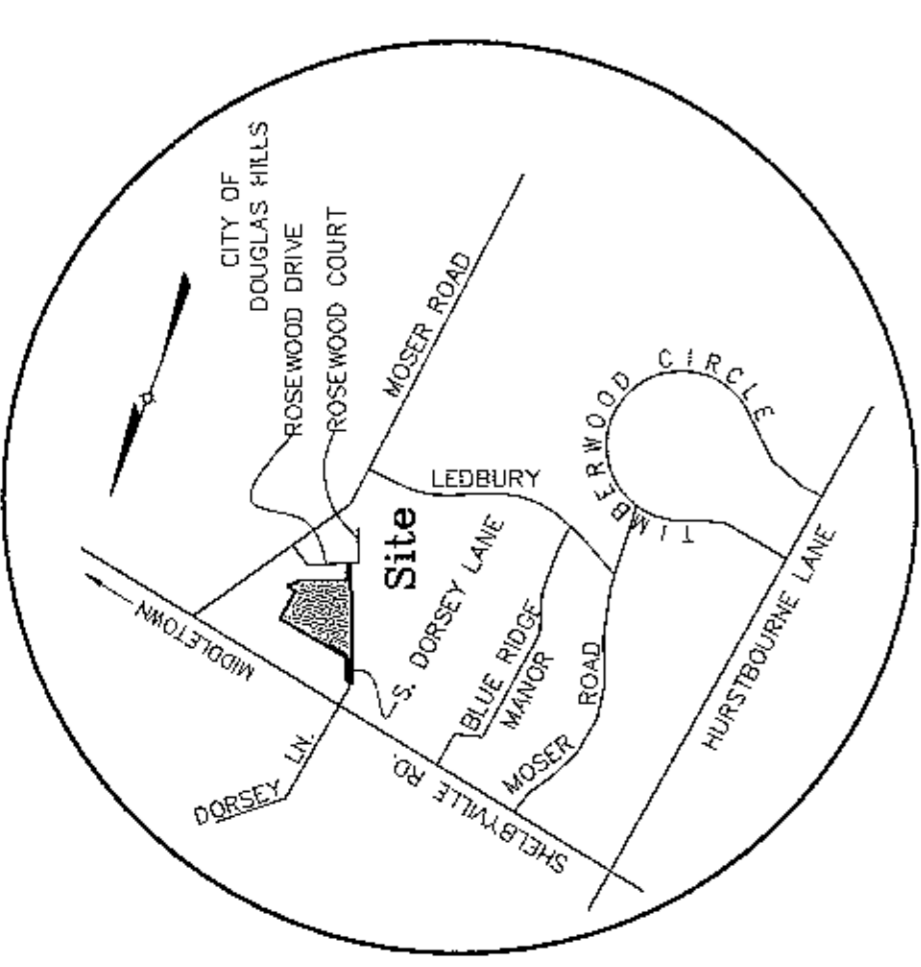


LOCATION MAP  
NO SCALE

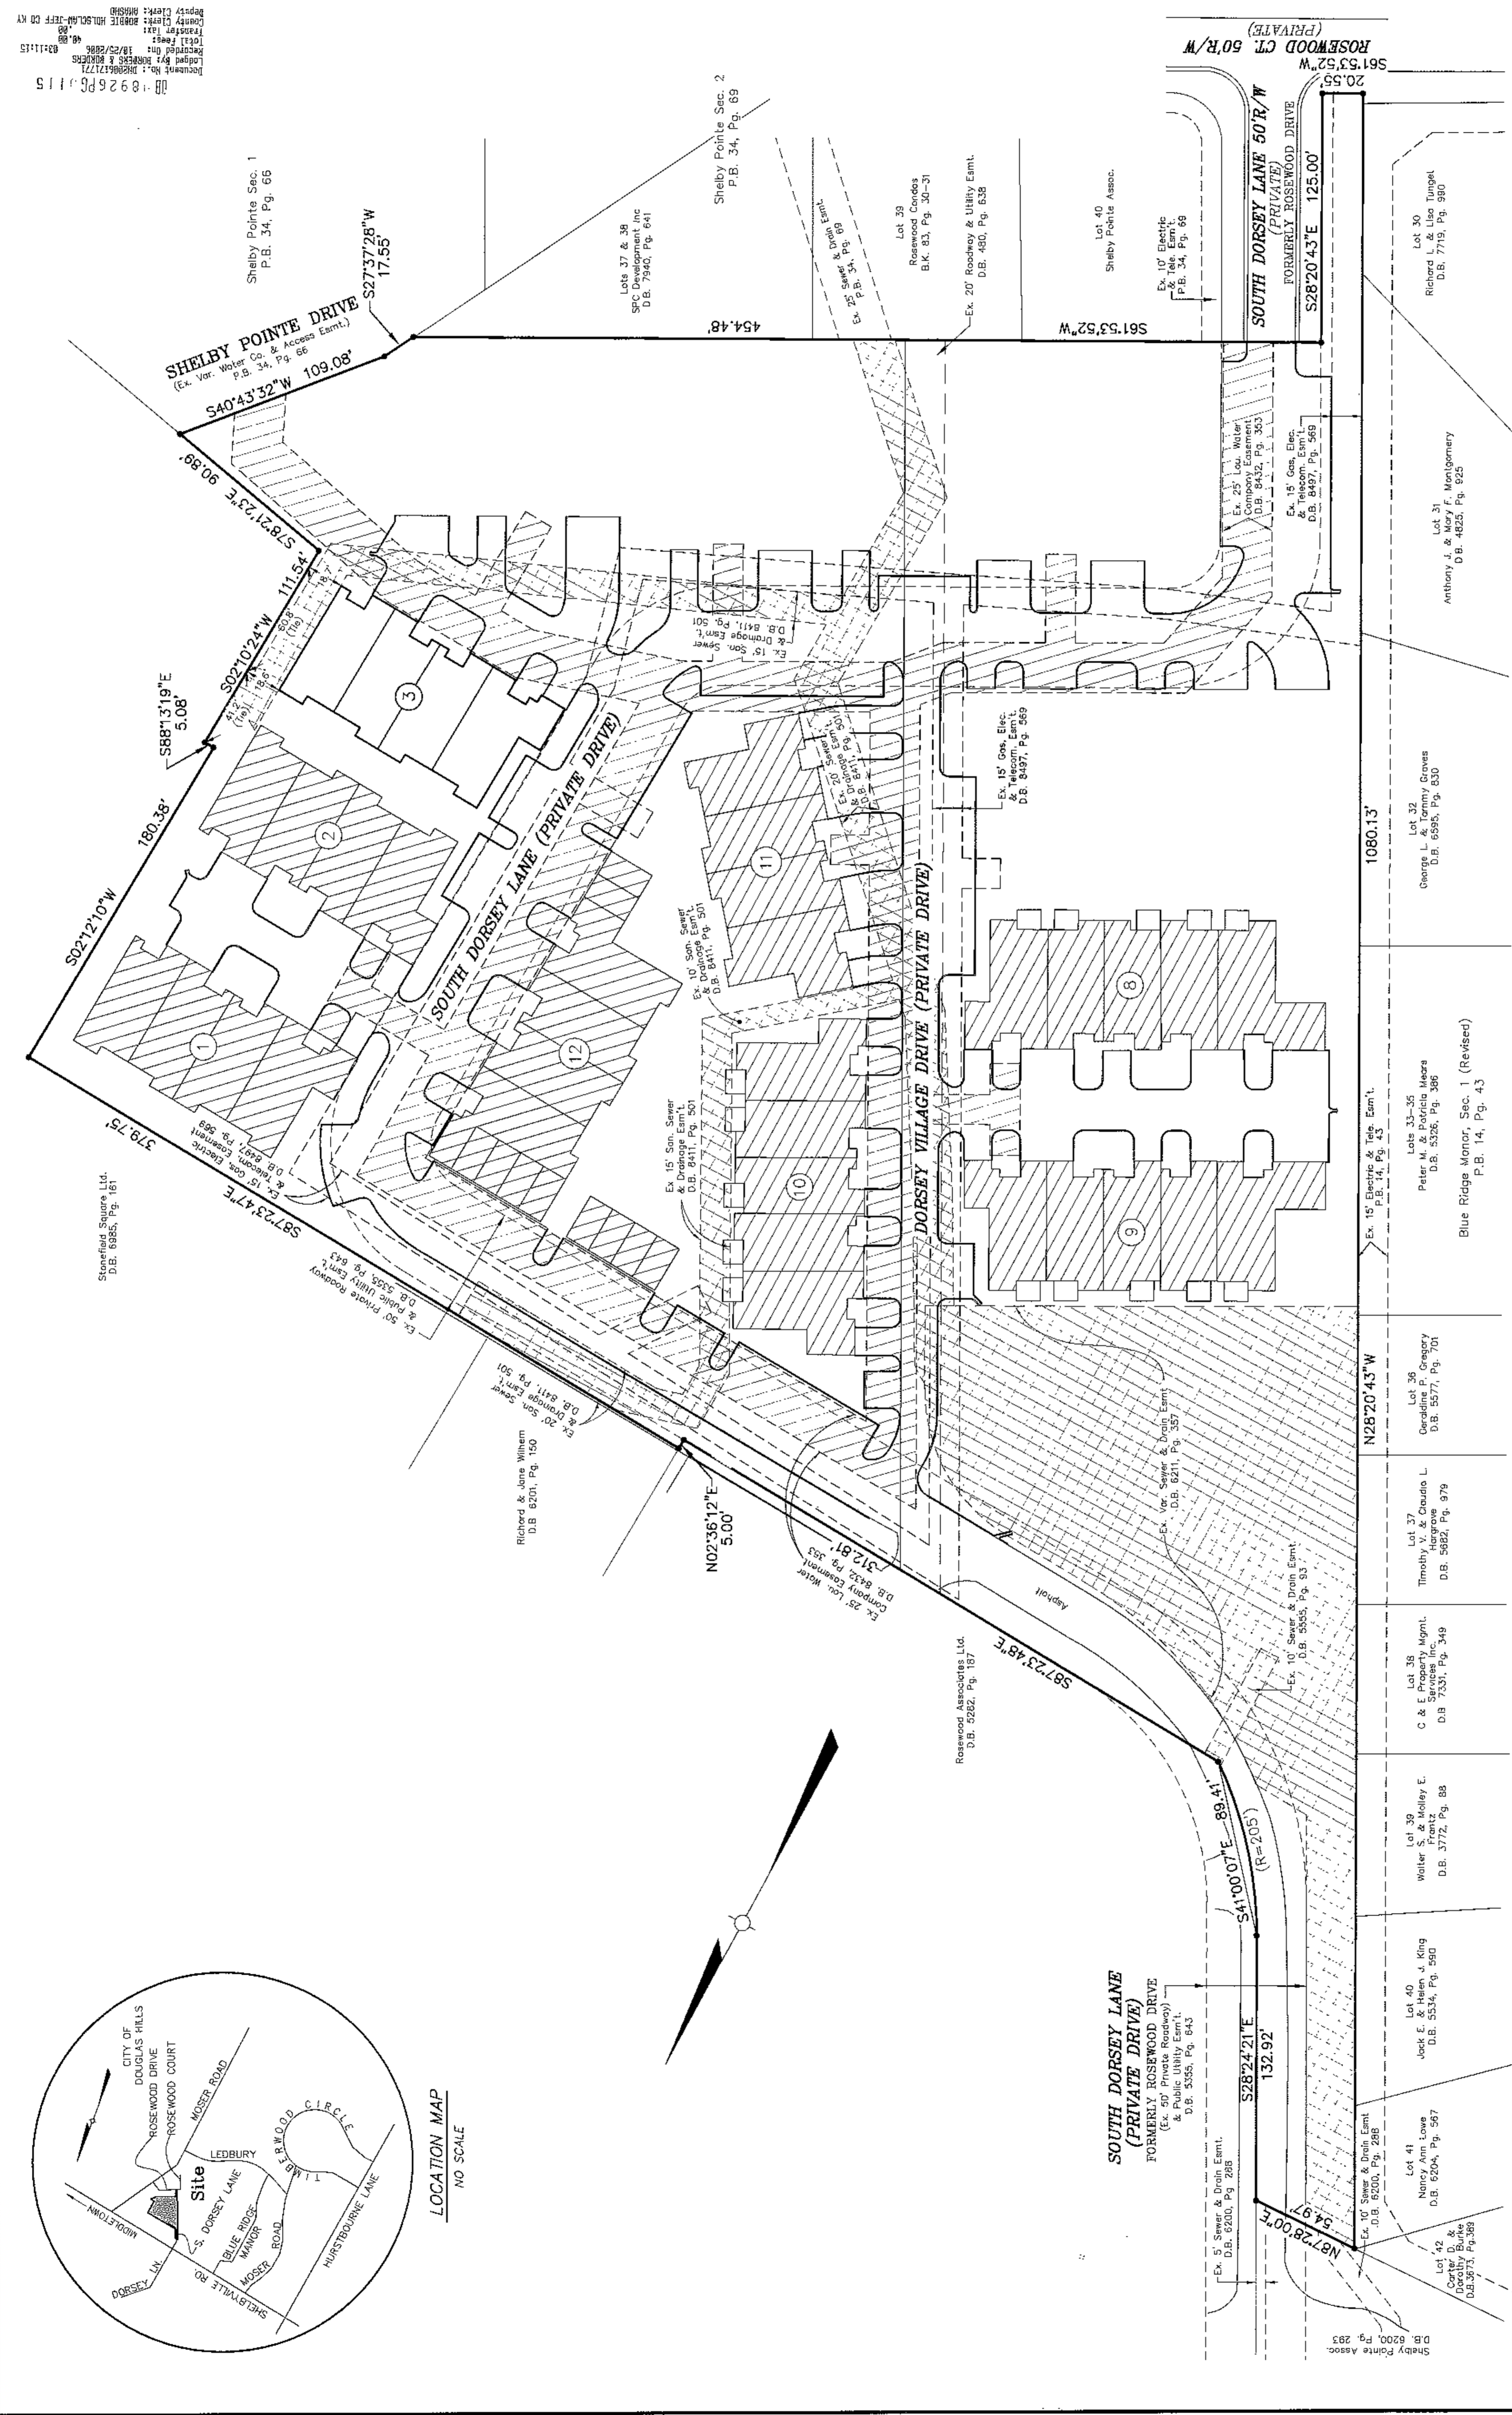

- GENERAL NOTES:**
- SEE SHEET 2 FOR OVERALL DIMENSIONS OF BUILDING 3.
  - ALL INTERIOR ANGLES OF CONDOMINIUMS ARE 90 DEGREES OR AS SHOWN.
  - EACH CONDOMINIUM UNIT CONSISTS OF SPACE BOUNDED BY A VERTICAL PROJECTION OF THE CONDOMINIUM UNIT BOUNDARY LINES AS SHOWN BY THE HORIZONTAL PLANES AT THE FLOOR AND CEILING ELEVATIONS OR AS SHOWN.

LEGEND  
③ - BUILDING NUMBER  
G-5 - GARAGE "UNIT NUMBER"

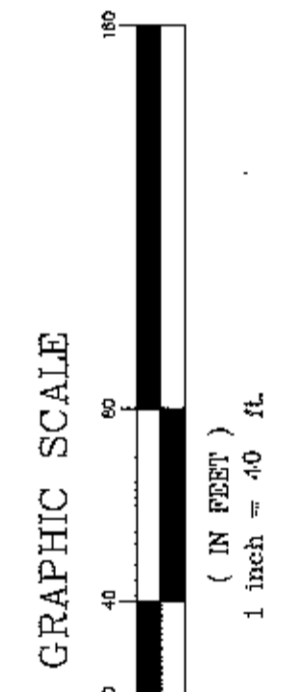

**SURVEYOR'S CERTIFICATE**

I HEREBY CERTIFY THAT THE SURVEY FOR THIS PLAT FOR BUILDINGS WAS MADE UNDER MY SUPERVISION AND THAT THE DIMENSIONS SHOWN HEREON WERE ESTABLISHED FROM RECORDS AND EXISTING MONUMENTS FOUND IN THE KNOWLEDGE AND BELIEF. THIS SURVEY MEETS OR EXCEEDS THE MINIMUM STANDARDS OF GOVERNING AUTHORITIES.

**DAVID D. BELL**  
#3492 B-9-06  
LICENSED PROFESSIONAL SURVEYOR  
DATE

**ENGINEER'S CERTIFICATE**

I HEREBY CERTIFY THAT THIS IS A TRUE AND ACCURATE COPY OF THE DRAWINGS AND PLANS OF BUILDING "3" AND THAT THE DIMENSIONS AND DIMENSIONS OF THE UNIT THESE PLANS FULLY AND ACCURATELY DEPICT THE LAYOUT, LOCATION AND DIMENSIONS OF THE UNITS AS BUILT.

**SCOTT A. SPEARS**  
#15227  
LICENSED PROFESSIONAL ENGINEER  
DATE

THE VERIFICATION AND CERTIFICATION WAS SWORN TO BEFORE ME BY DAVID D. BELL SURVEYOR OF LAND DESIGN & DEVELOPMENT, INC. ON THE DAY OF 16 2006 MY COMMISSION EXPIRES 01 16 2006

**DAVID D. BELL**  
NOTARY PUBLIC

THE VERIFICATION AND CERTIFICATION WAS SWORN TO BEFORE ME BY DAVID D. BELL SURVEYOR OF LAND DESIGN & DEVELOPMENT, INC. ON THE DAY OF 16 2006 MY COMMISSION EXPIRES 01 16 2006

**DAVID D. BELL**  
NOTARY PUBLIC

**DORSEY VILLAGE CONDOMINIUMS**  
DEVELOPER  
**DORSEY VILLAGE LLC**  
14407 WILLOW GROVE CIRCLE  
LOUISVILLE, KENTUCKY 40245  
PHONE: (502) 551-0569

**LAND DESIGN & DEVELOPMENT, INC.**  
LAND DESIGN & DEVELOPMENT, INC.  
204 WENDELL AVENUE  
LOUISVILLE, KENTUCKY 40202  
PHONE: 502-414-9784  
FAX: 502-414-9785

PROJECT DATA

FILE NAME	03139.CONDOM.DWG
SCALE	1"=40'
DATE	AUG. 09, 2006
CHECKED BY	PPP
DRAWN BY	PPP

ENGINEER'S SEAL  
SURVEYOR'S SEAL

REVISIONS

NO.	DATE	DESCRIPTION	BY

JOB NO.  
**03139**  
SHEET  
**1**  
OF  
**2**

Recorded in Cadd Book  
No. 117 Page 40  
Part No. 2331

Recording No.: 08926 Pg. 115  
Lender: PZ BANKS & ASSOCIATES  
18/25/2006  
Total Fees: 40.00  
Recorder: 031115

FLOOR PLAN - BUILDING "3"  
DORSEY VILLAGE CONDOMINIUMS  
DEVELOPER:  
DORSEY VILLAGE LLC  
14407 WILLOW GROVE CIRCLE  
LOUISVILLE, KENTUCKY 40245  
PHONE: (502) 551-0569

**L D & D**  
LAND DESIGN & DEVELOPMENT, INC.  
ENGINEERING, LAND SERVICES, LANDSCAPE ARCHITECTURE  
204 WILLOW GROVE LANE, LOUISVILLE, KENTUCKY 40245  
PHONE: (502) 551-0569 FAX: (502) 551-0578

PROJECT DATA  
FILE NAME: BUILDING3.dwg  
DATE: AUG. 9, 2006  
SCALE: 1/8" = 1'-0"  
DRAWN BY: PDP  
CHECKED BY: PDP



ENGINEER'S SEAL  
SURVEYOR'S SEAL

REVISIONS

NO.	DATE	DESCRIPTION	BY

02 - 6925 PG. 115  
Recorded in County Book  
No. 117 Page 41  
Form No. 2331

Recorded by: ROBERT S. BOWEN  
Recorded Date: 10/25/2006  
40.00  
03:11:15  
County Clerk: ROBERT HOLSTADT-REFF CO KY  
Notary Clerk: RICHIE

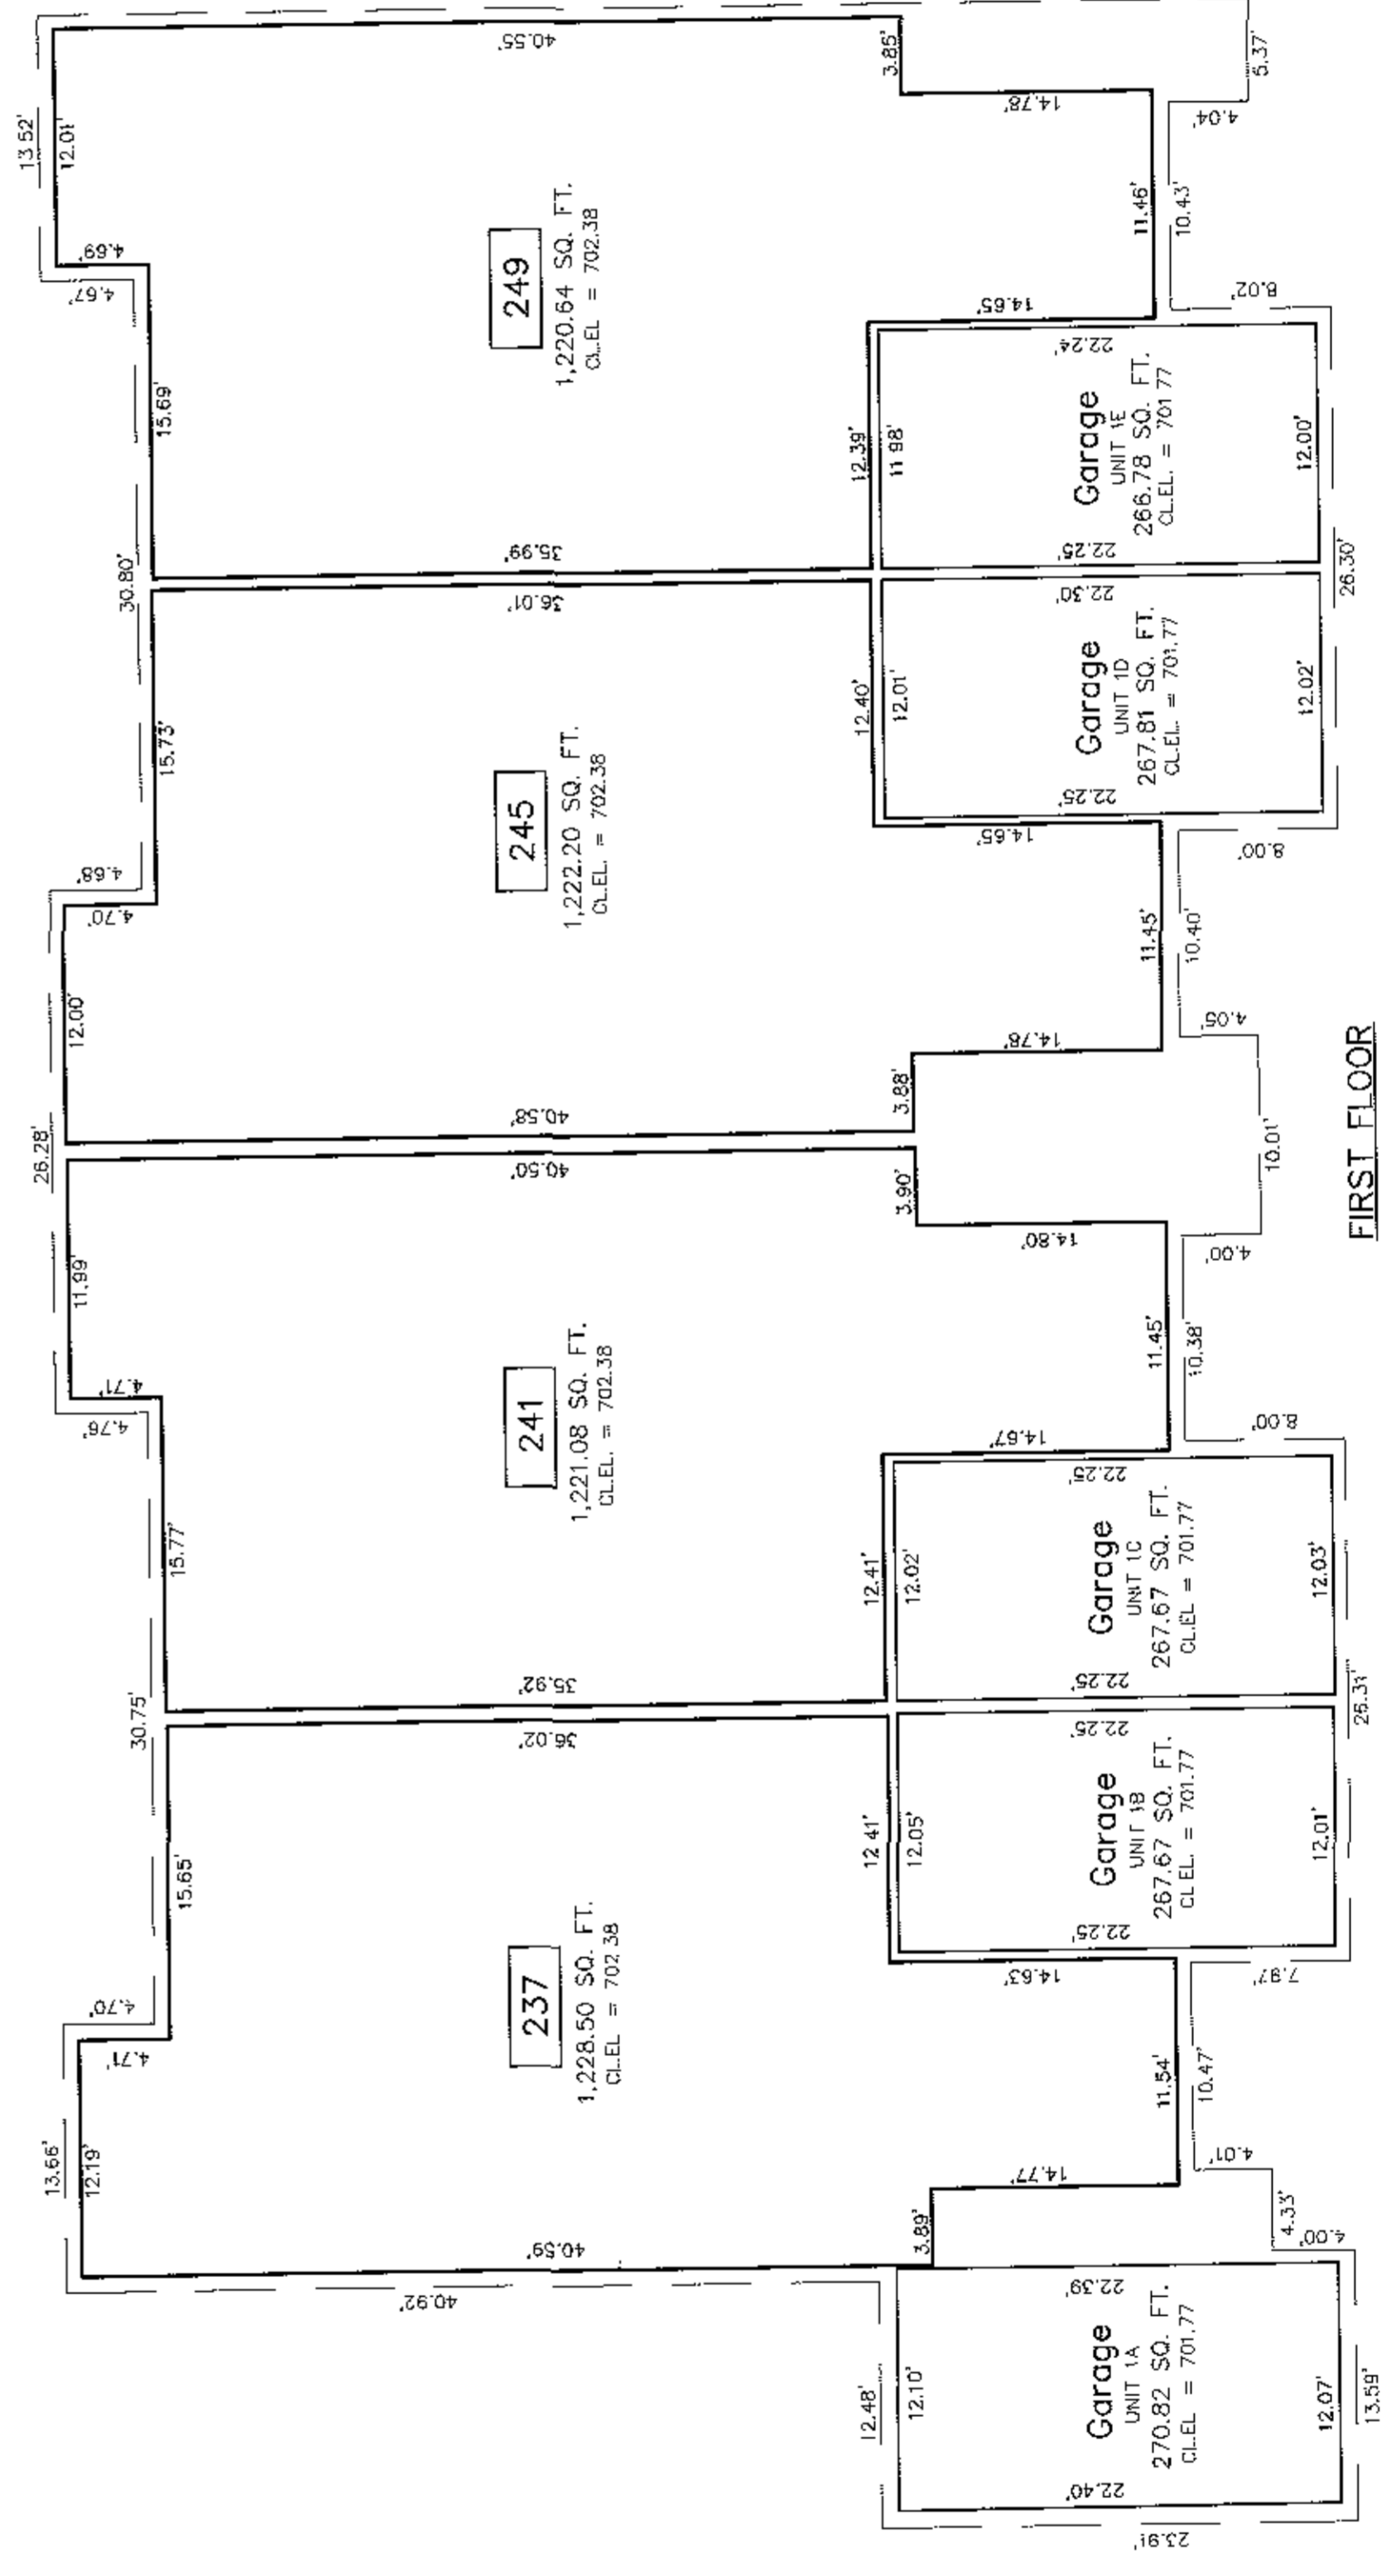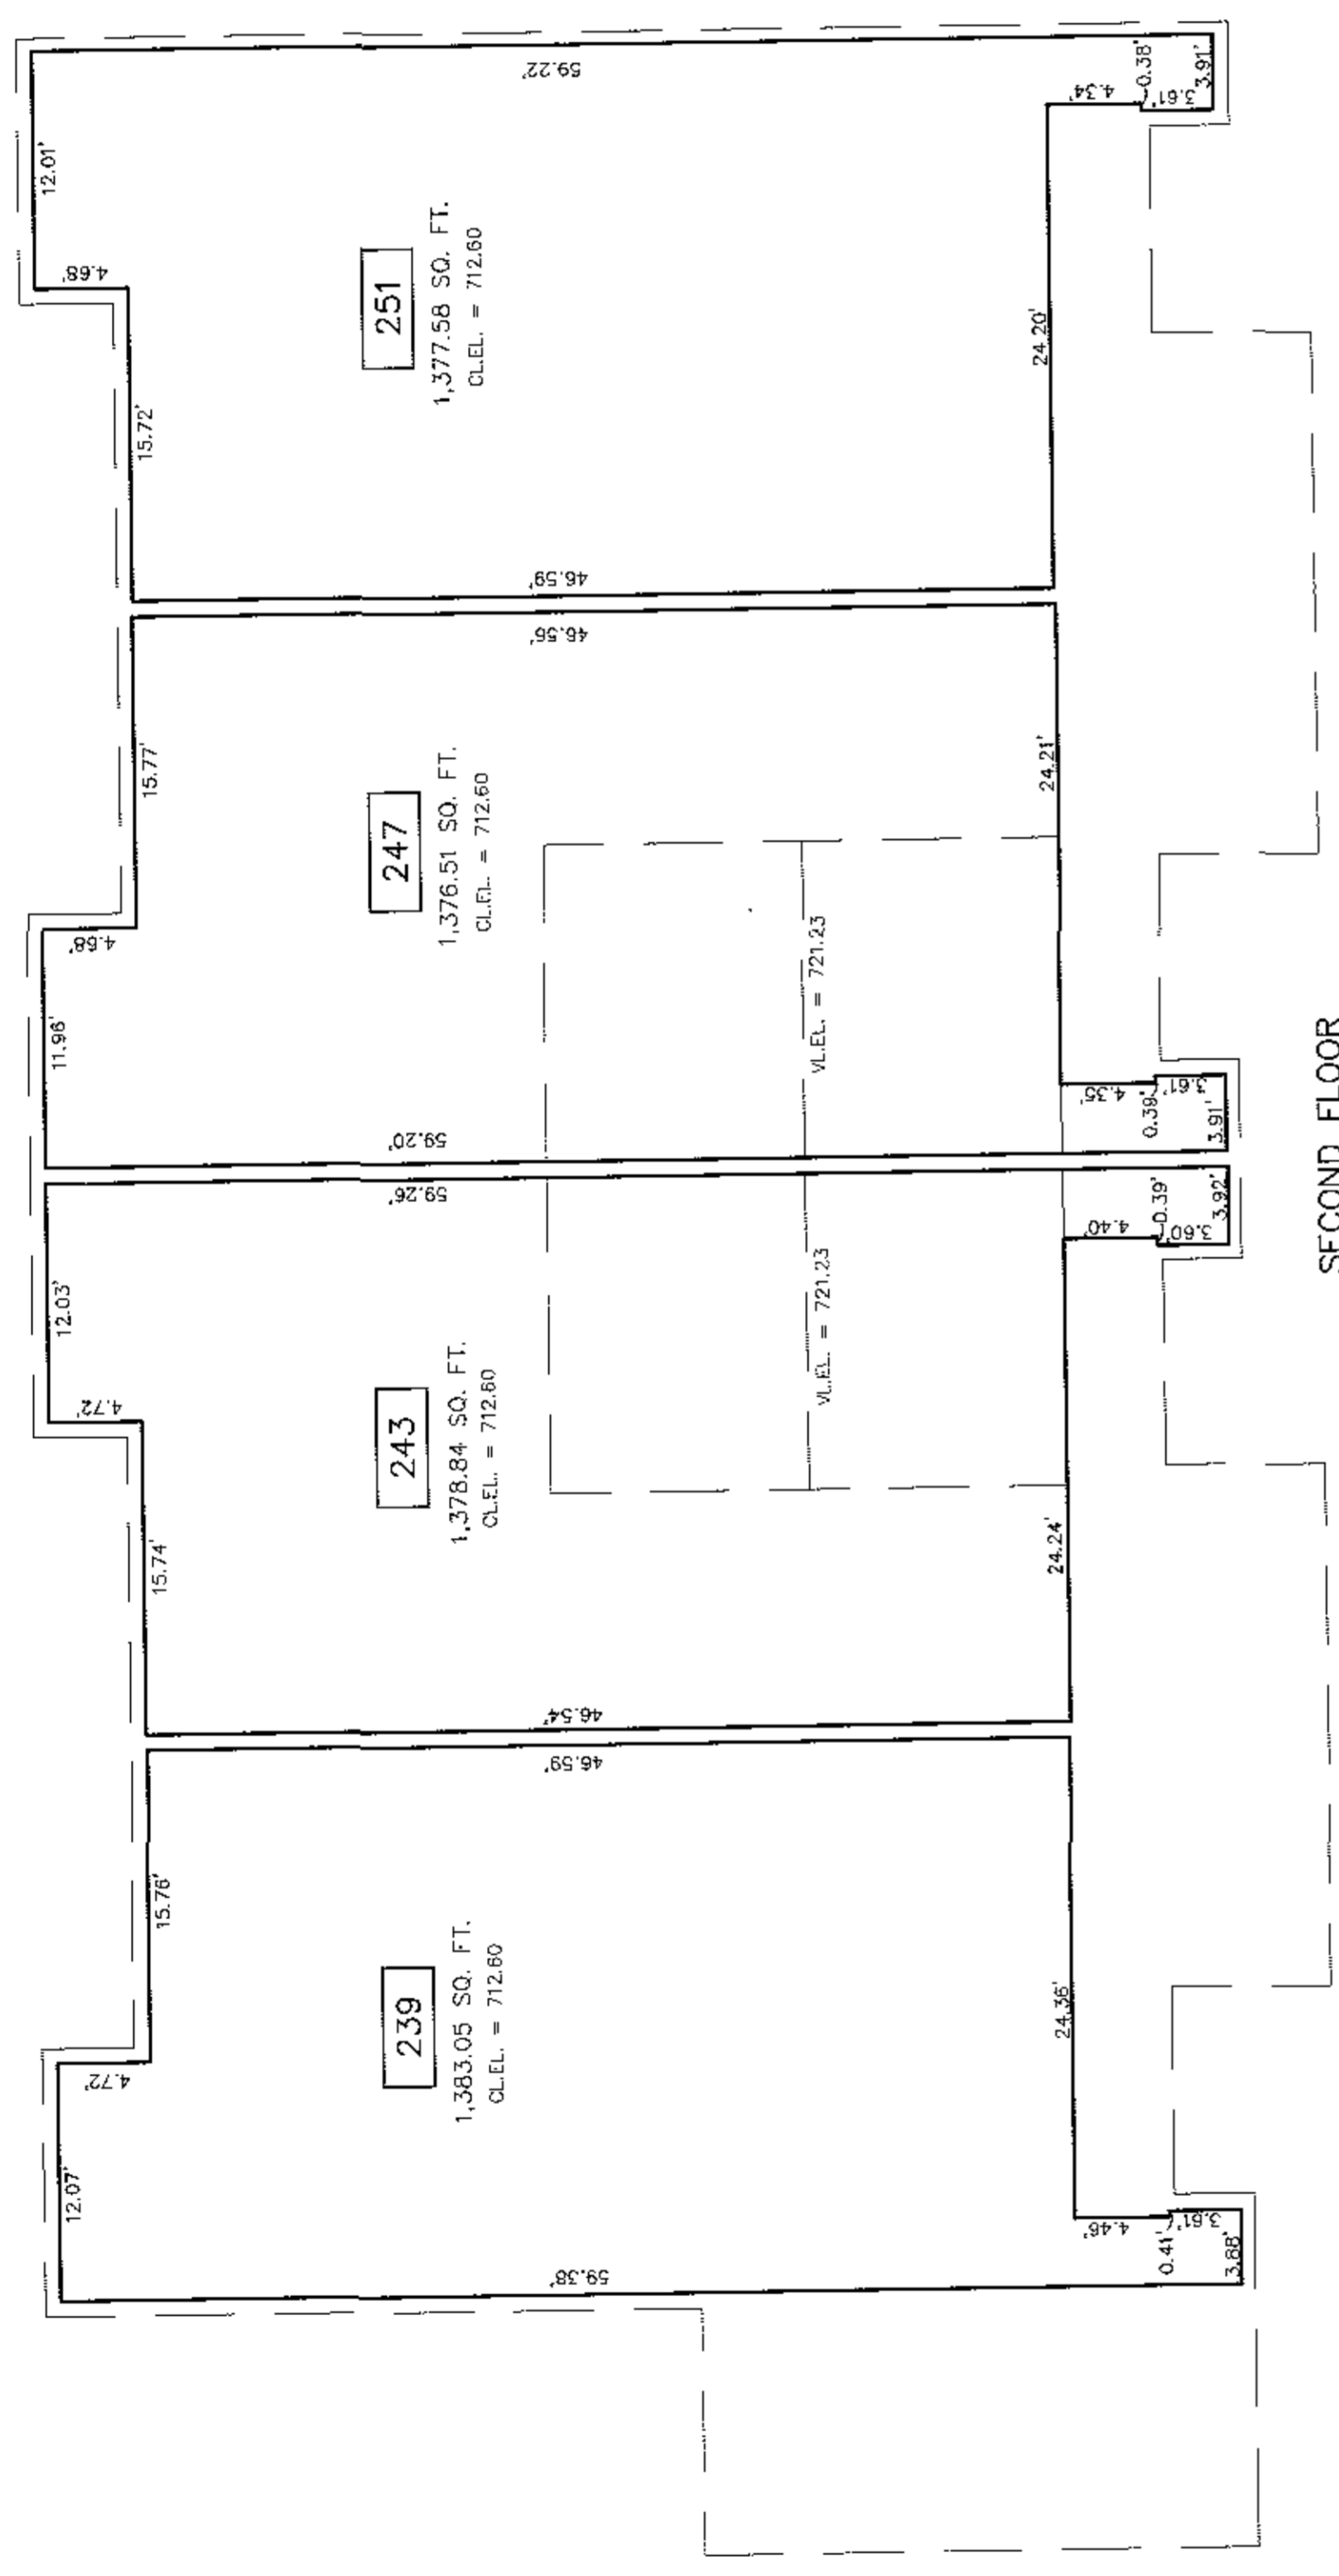

**LEGEND**

- 237 - UNIT NUMBER
- C.E.L. - CEILING ELEVATION
- - - LIMITS OF OWNERSHIP
- - - LIMITS OF COMMON SPACE (BUILDING EXTERIOR)

117 X 41

117 X 41

117 X 41