



52x811

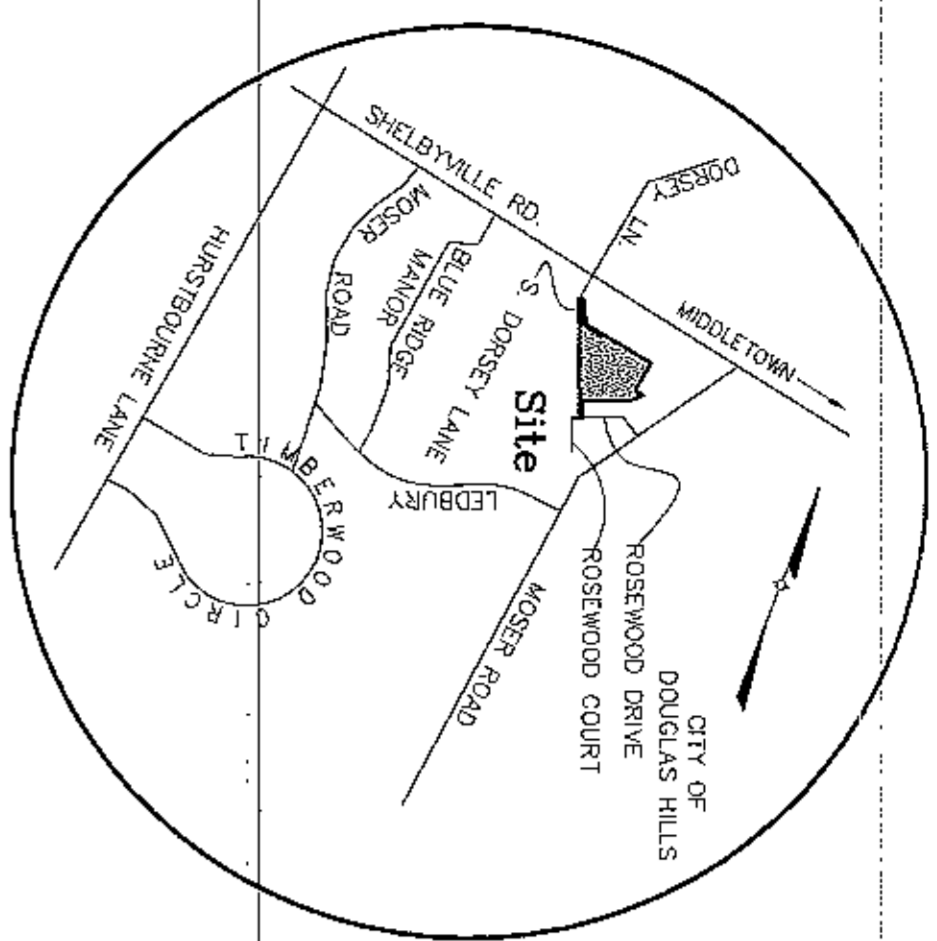


LOCATION MAP
NO SCALE

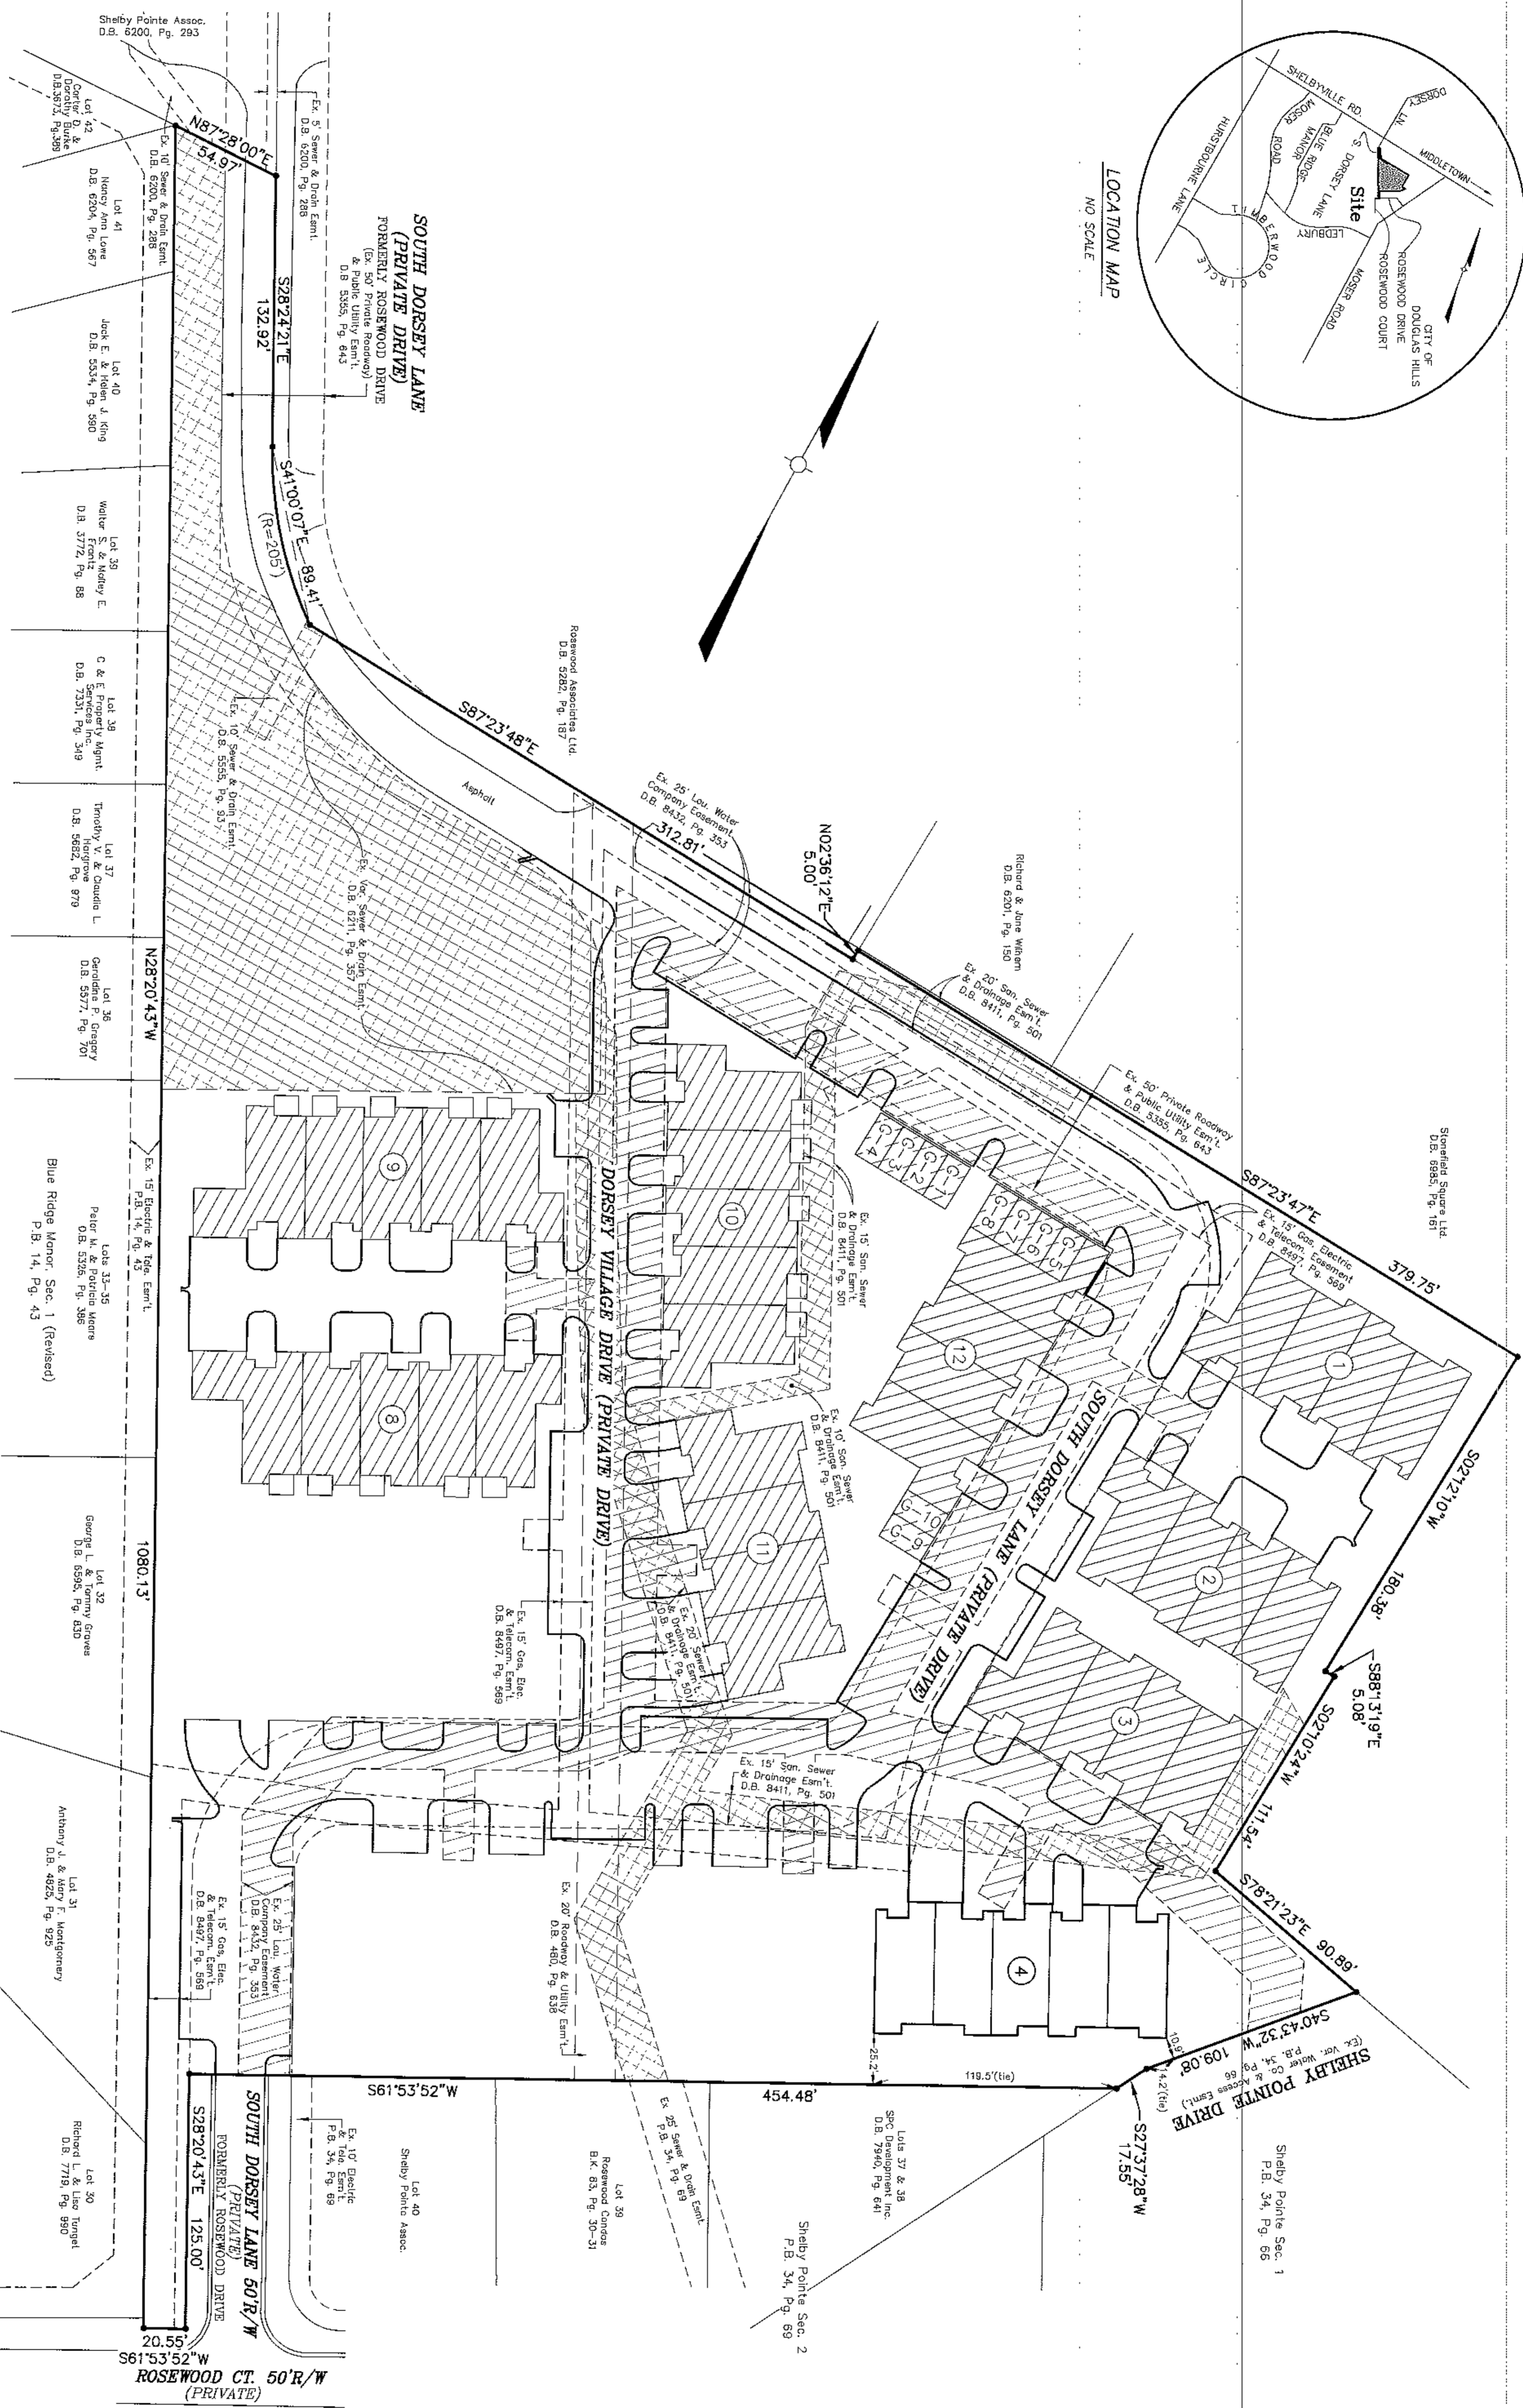

- GENERAL NOTES:**
- 1) SEE SHEET 2 FOR OVERALL DIMENSIONS OF BUILDING 4.
 - 2) ALL INTERIOR ANGLES OF CONDOMINIUMS ARE 90 DEGREES OR AS SHOWN.
 - 3) EACH CONDOMINIUM UNIT CONSISTS OF SPACE BOUNDED BY A VERTICAL PROJECTION OF THE CONDOMINIUM UNIT BOUNDARY LINES AS SHOWN BY THE HORIZONTAL PLANES AT THE FLOOR AND CEILING ELEVATIONS OR AS SHOWN.

Recorded in Condo Book
No. 118 Page 25
Plan No. 2514

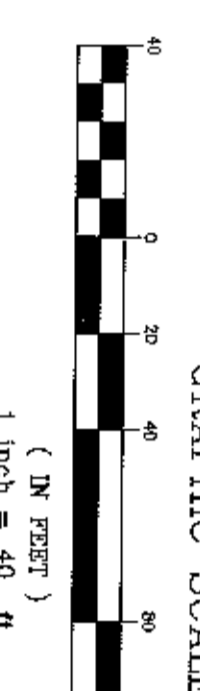

GRAPHIC SCALE
1 inch = 40 feet

LEGEND

④ - BUILDING NUMBER

⑤ - GARAGE "UNIT NUMBER"

SURVEYOR'S CERTIFICATE

I HEREBY CERTIFY THAT THE SURVEY FOR THIS PLAT FOR BUILDINGS WAS MADE UNDER MY SUPERVISION AND THAT THE DIMENSIONS AND LOCATIONS OF THE BUILDINGS, THE VERTICAL ELEVATIONS SHOWN HEREON WERE ESTABLISHED FROM RECORDS AND EXISTING MONUMENTS FOUND IN THE KNOWLEDGE AND BELIEF OF THIS SURVEYOR TO BE THE MINIMUM STANDARDS OF GOVERNING AUTHORITIES.

David M. #3492 10-23-06
DATE

ENGINEER'S CERTIFICATE

I HEREBY CERTIFY THAT THIS IS A TRUE AND ACCURATE COPY OF THE DRAWINGS AND PLANS OF BUILDING "4" AS SHOWN FULLY AND ACCURATELY DEPICT THE LAYOUT, LOCATION AND DIMENSIONS OF THE UNITS AS BUILT.

Scott A. #16227
DATE



ENGINEER'S CERTIFICATE

I HEREBY CERTIFY THAT THIS IS A TRUE AND ACCURATE COPY OF THE DRAWINGS AND PLANS OF BUILDING "4" AS SHOWN FULLY AND ACCURATELY DEPICT THE LAYOUT, LOCATION AND DIMENSIONS OF THE UNITS AS BUILT.

Scott A. #16227
DATE

JOB NO.
03139

SHEET
1
OF 2

SITE PLAN - BUILDING "4"

DORSEY VILLAGE CONDOMINIUMS

DEVELOPER:
DORSEY VILLAGE LLC
14407 WILLOW GROVE CIRCLE
LOUISVILLE, KENTUCKY 40245
PHONE: (502) 551-0569

LD&D
LAND DESIGN & DEVELOPMENT, INC.
ENGINEERING - LAND SURVEYING - LANDSCAPE ARCHITECTURE
8014 VINECREST AVENUE, LOUISVILLE, KENTUCKY 40222
PHONE: 502-416-2914 FAX: 502-416-2975

PROJECT DATA

FILE NAME: 03139condo.dwg	SCALE: 1"=40'
DATE: 10/23/06	DRAWN BY: PDP
CHECKED BY: O.Z.	

ENGINEER'S SEAL

SURVEYOR'S SEAL

REVISIONS

NO.	DATE	DESCRIPTION	BY

52x811

118x25

92x811

LEGEND

4A - GARAGE UNIT NUMBER



301 - UNIT NUMBER

V.E.L. - VAULT ELEVATION

C.E.L. - CEILING ELEVATION

--- LIMITS OF OWNERSHIP

--- LIMITS OF COMMON SPACE (BUILDING EXTERIOR)

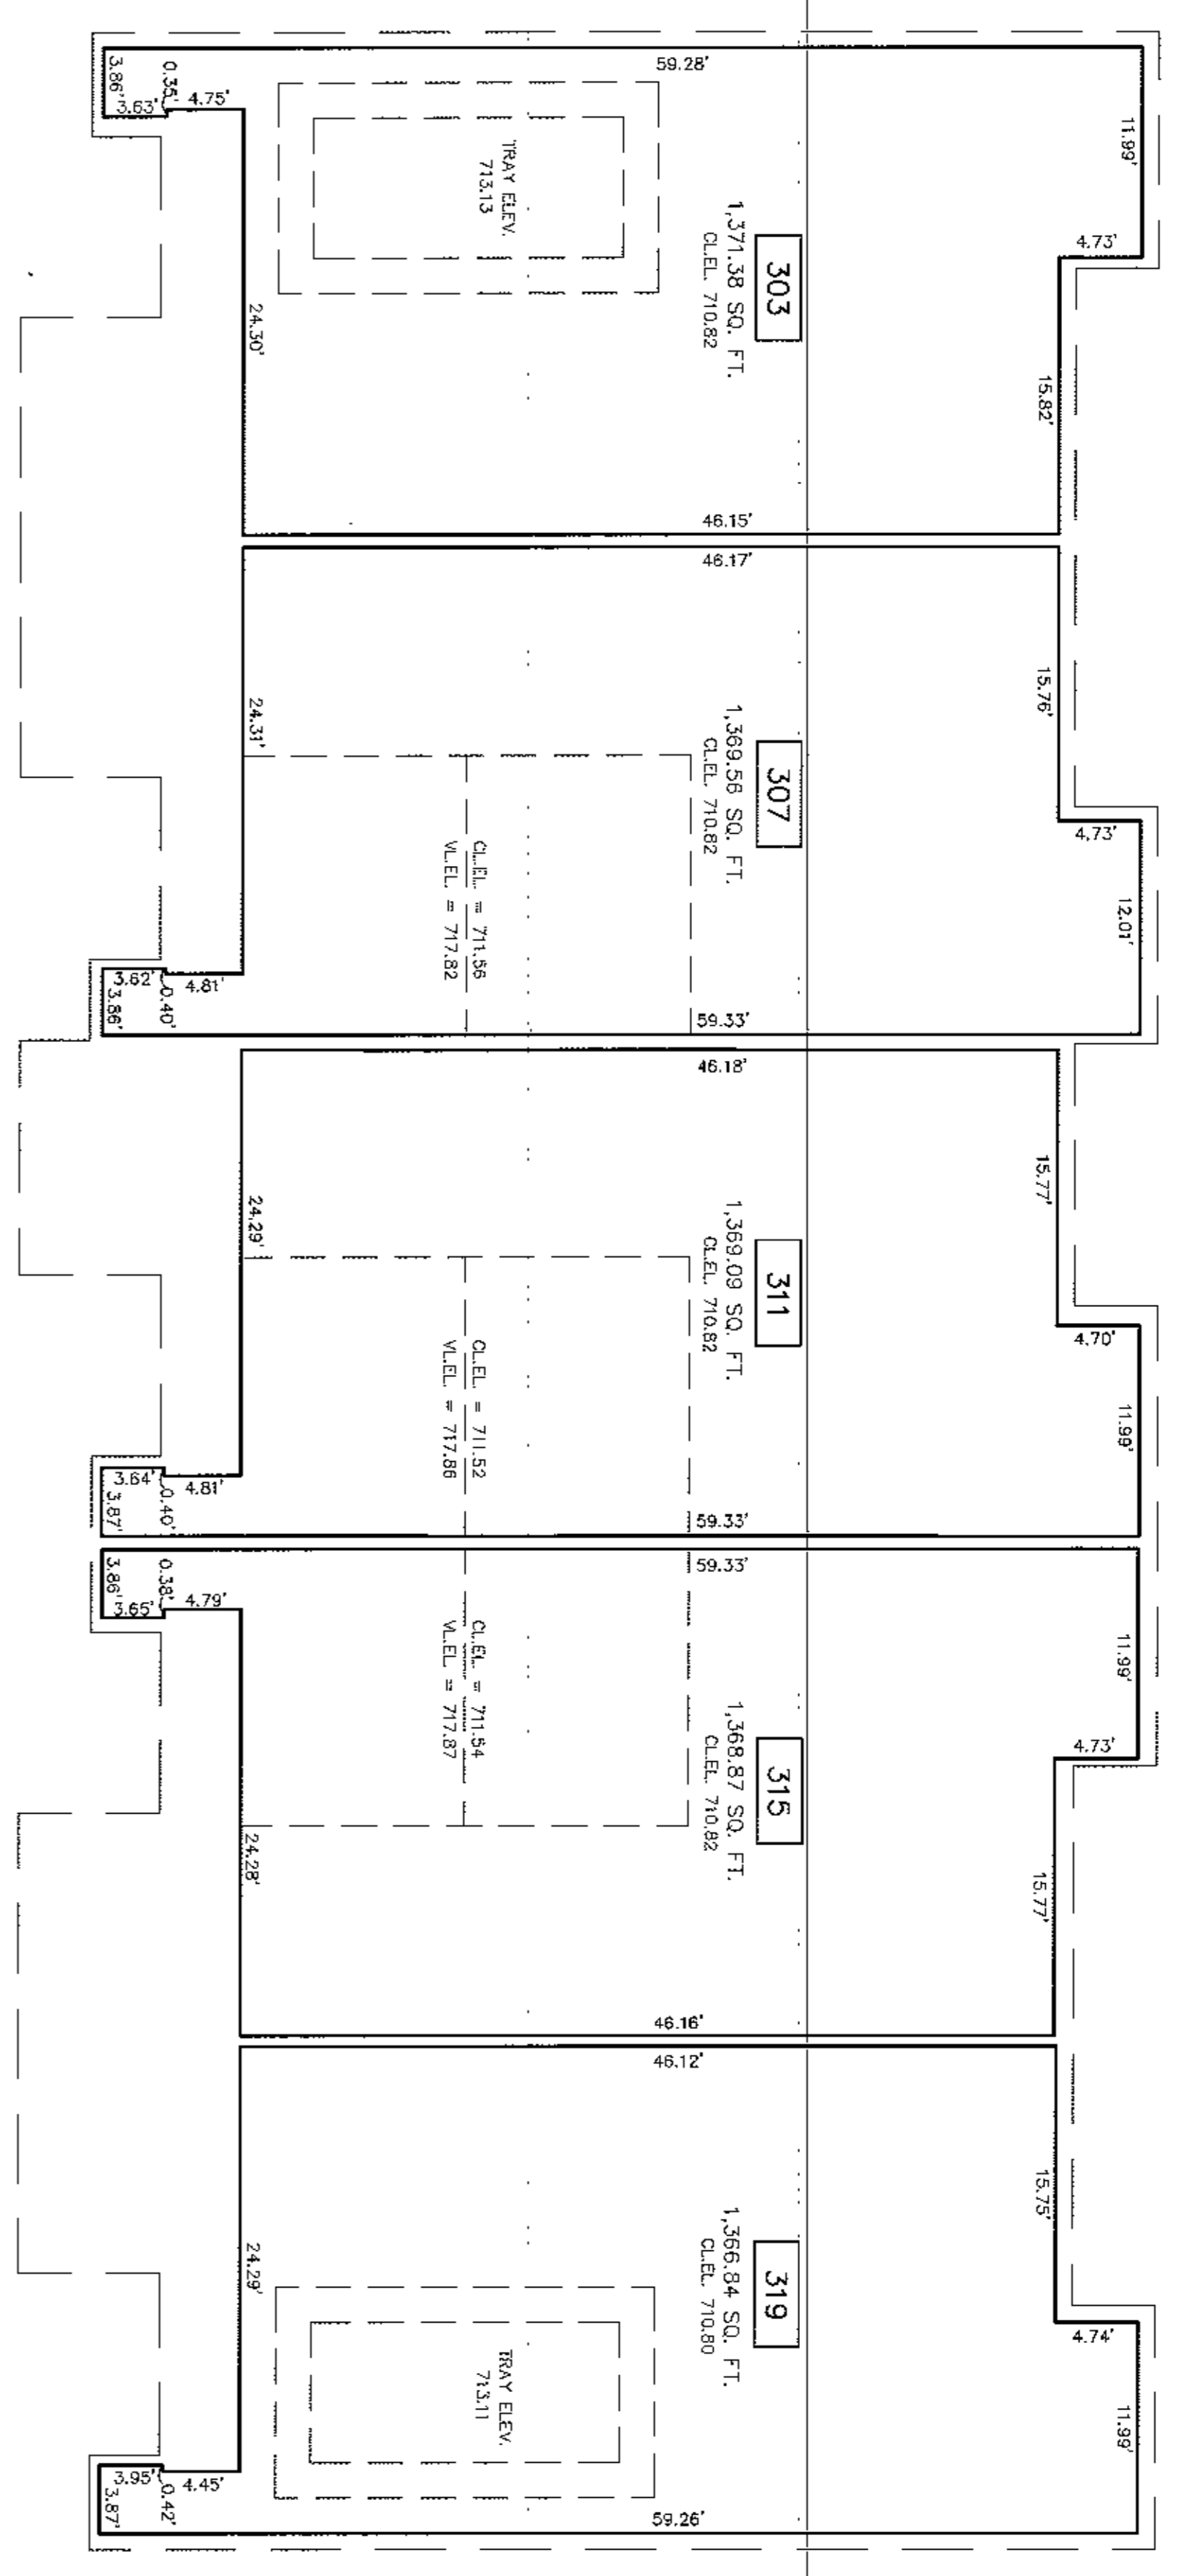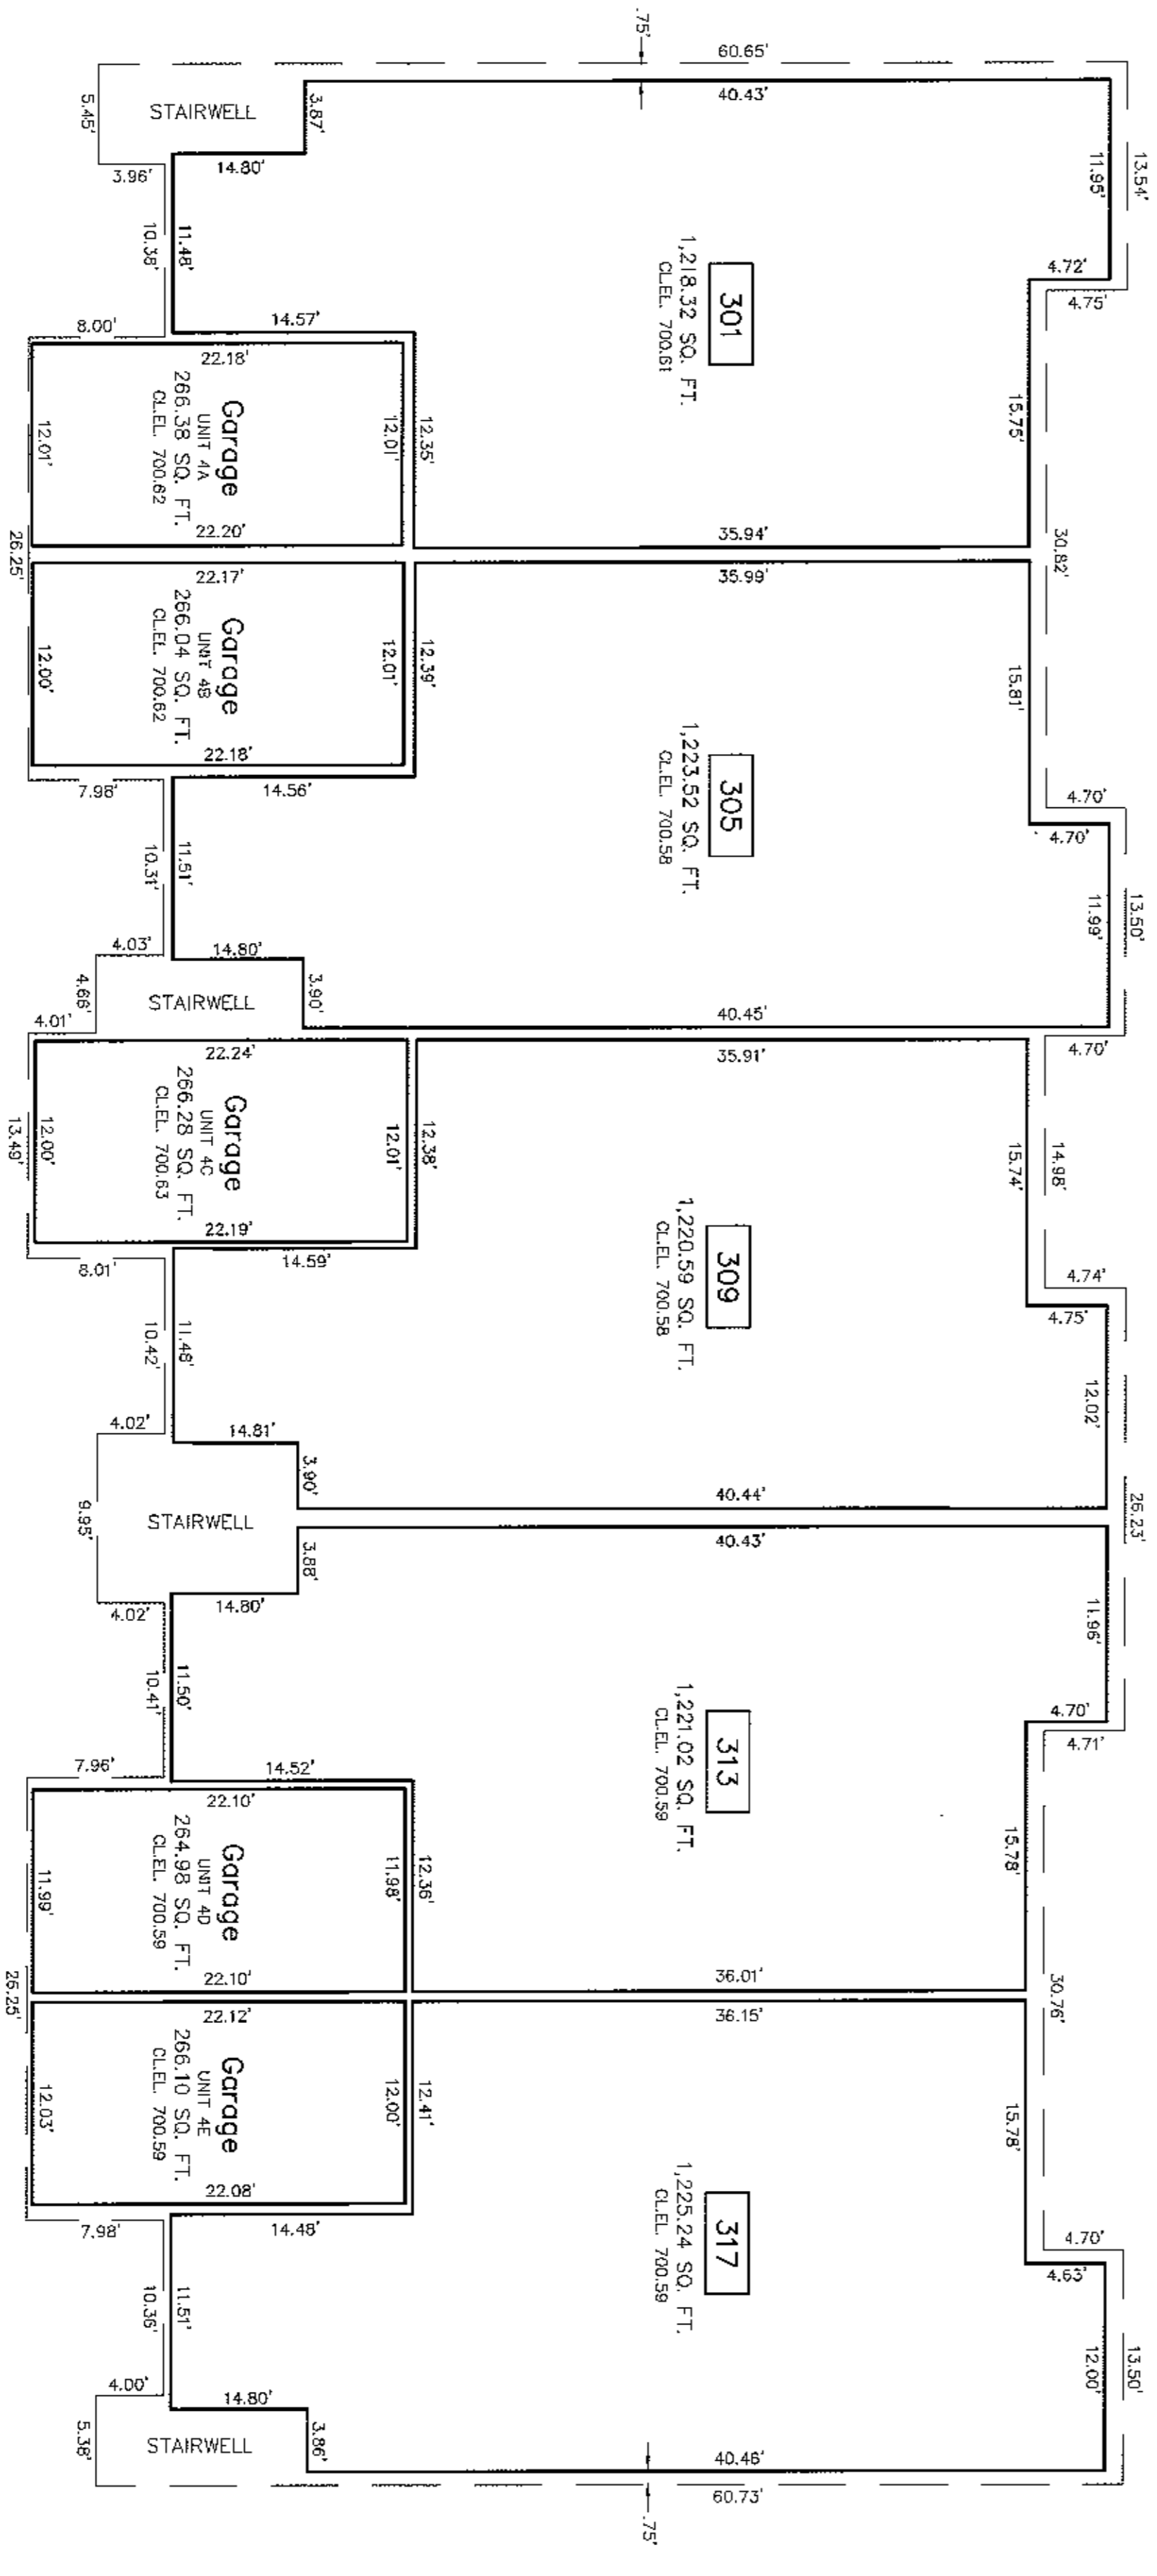

92x811

118x26


JOB NO. 03139

SHEET 2 OF 2

FLOOR PLAN - BUILDING "4"

DORSEY VILLAGE CONDOMINIUMS

DEVELOPER:
DORSEY VILLAGE LLC
14407 WILLOW GROVE CIRCLE
LOUISVILLE, KENTUCKY 40245
PHONE: (502) 551-0569

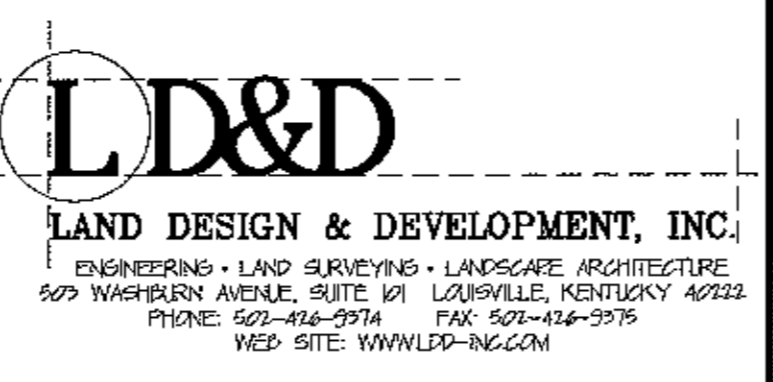

PROJECT DATA

FILE NAME: BUILDING4.dwg

DATE: OCT. 23, 2006 SCALE: 1/8"=1'-0"

CHECKED BY: O.Z. DRAWN BY: PDP

ENGINEER'S SEAL

SURVEYOR'S SEAL

REVISIONS			
NO.	DATE	DESCRIPTION	BY

118x26