
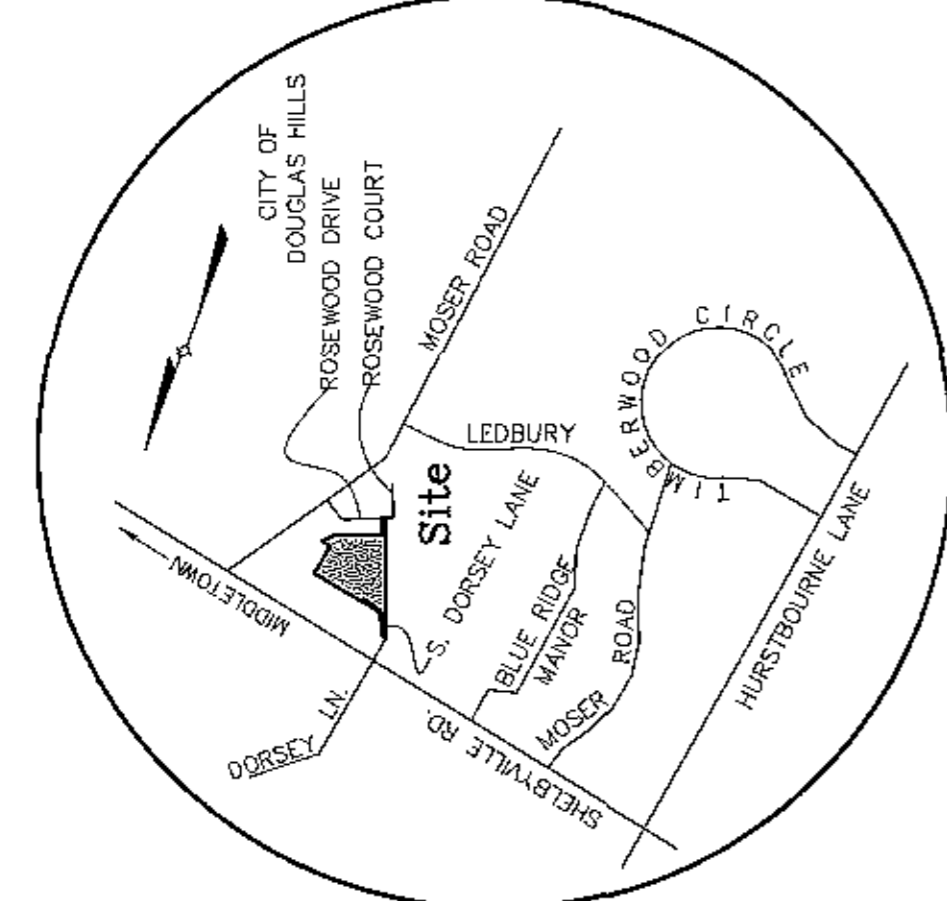


52 x 801

108 x 25

108 x 25

108 x 25

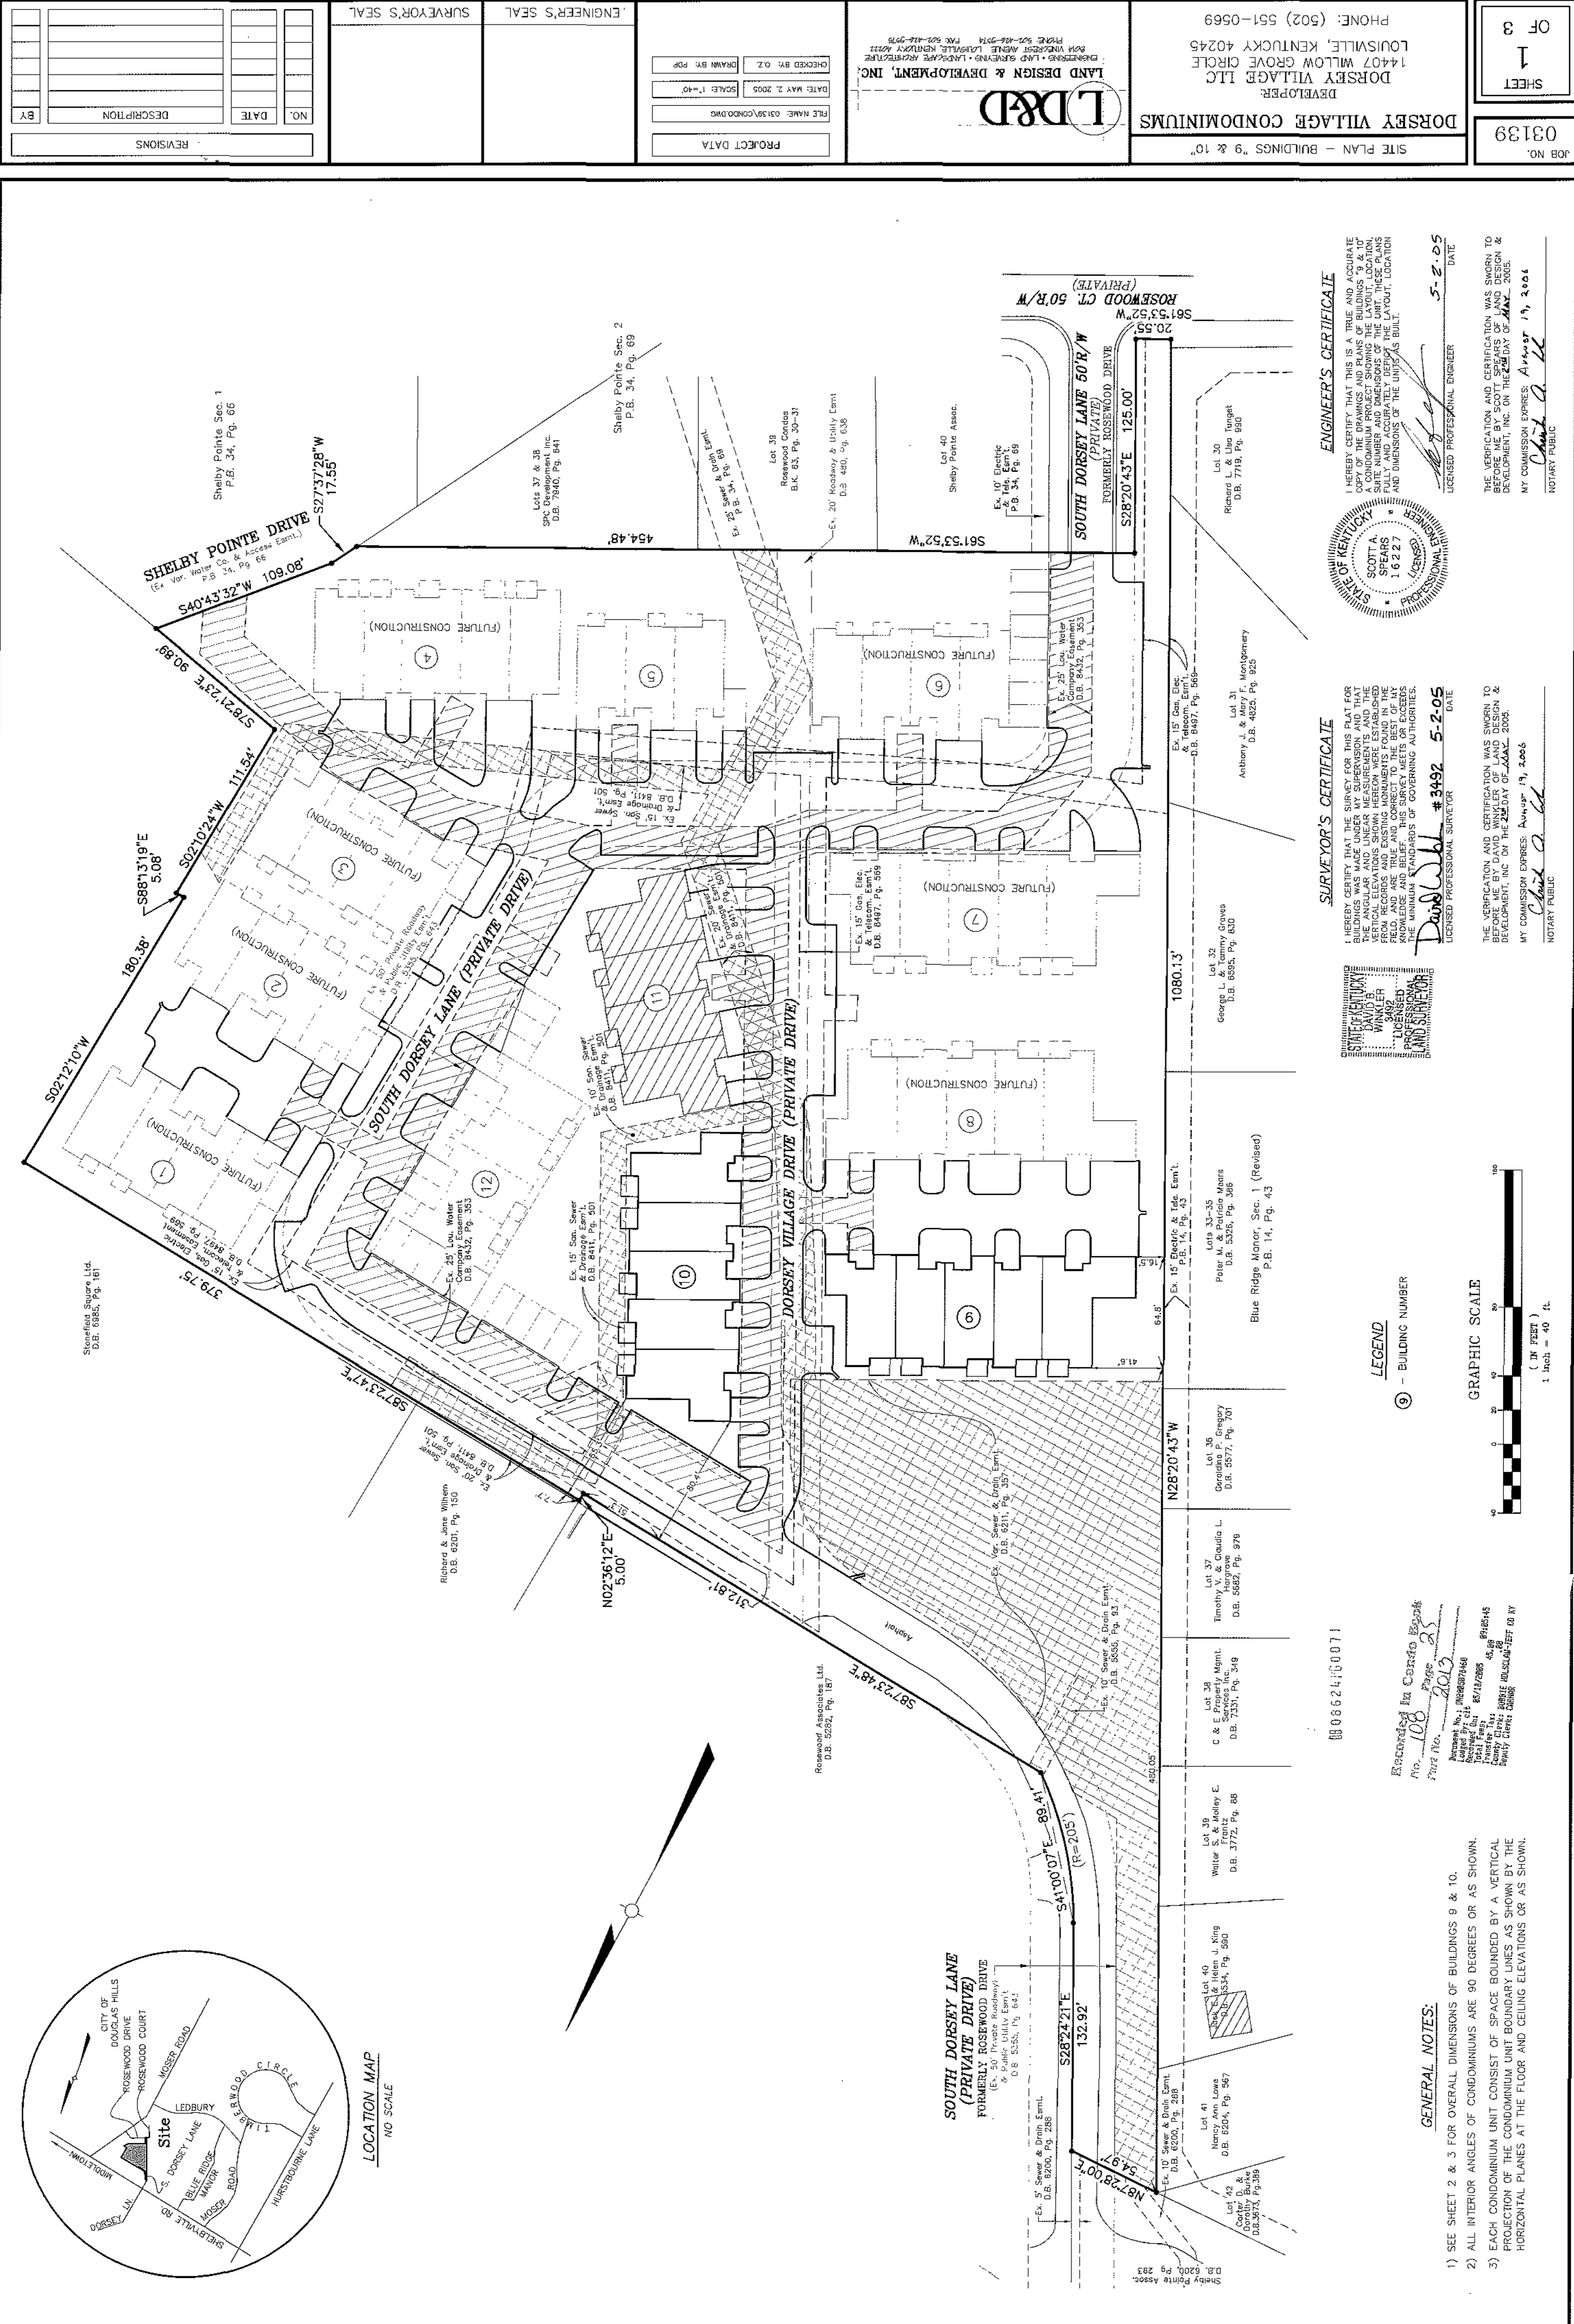

LOCATION MAP
NO SCALE

ENGINEER'S CERTIFICATE

I HEREBY CERTIFY THAT THIS IS A TRUE AND ACCURATE SURVEY OF THE CONDOMINIUM PROJECT SHOWN ON THE LAYOUT, LOCATION, SITE NUMBER AND DIMENSIONS OF THE UNIT, THESE PLANS AND DIMENSIONS OF THE UNIT AS BUILT.

DATE: 5-2-05
 LICENSED PROFESSIONAL ENGINEER: [Signature]


THE VERIFICATION AND CERTIFICATION WAS SWORN TO BEFORE ME BY SCOTT SPEARS OF LAND DESIGN & DEVELOPMENT, INC. ON THE 2nd DAY OF MAY, 2005.
 MY COMMISSION EXPIRES: August 19, 2004
 NOTARY PUBLIC: [Signature]

SURVEYOR'S CERTIFICATE

I HEREBY CERTIFY THAT THE SURVEY FOR THIS PLAT FOR THE CONDOMINIUM PROJECT SHOWN HEREON WERE ESTABLISHED THE VERTICAL ELEVATIONS SHOWN HEREON WERE ESTABLISHED IN THE FIELD AND ARE TRUE AND CORRECT TO THE BEST OF MY KNOWLEDGE AND BELIEF. THIS SURVEY MEETS OR EXCEEDS THE MINIMUM STANDARDS OF GOVERNING AUTHORITIES.

DATE: 5-2-05
 LICENSED PROFESSIONAL SURVEYOR: [Signature]

THE VERIFICATION AND CERTIFICATION WAS SWORN TO BEFORE ME BY DAVID WINKLER OF LAND DESIGN & DEVELOPMENT, INC. ON THE 2nd DAY OF MAY, 2005.
 MY COMMISSION EXPIRES: August 19, 2005
 NOTARY PUBLIC: [Signature]

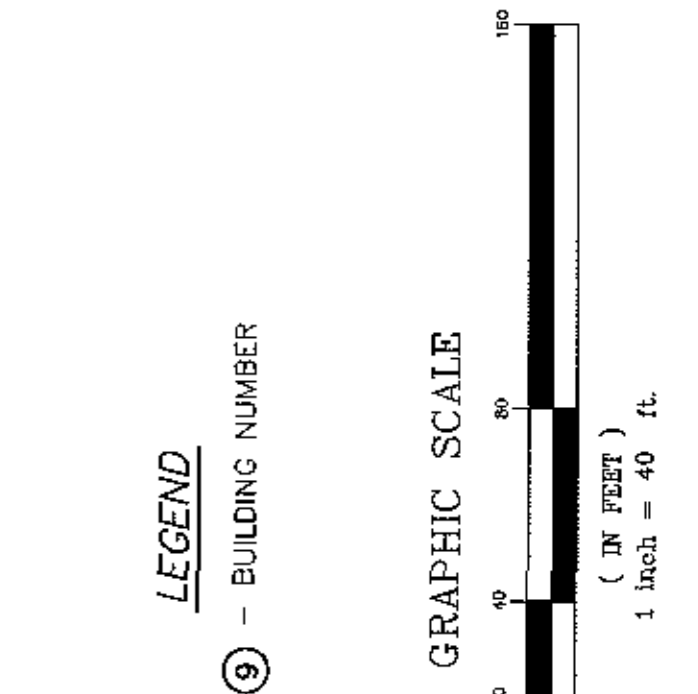

Expanded in Condo Book
 At: 108 Page 25
 Date Rec: 2013
 Document No: 108207946
 Registered On: 8/17/2005
 Surveyor: David Winkler
 Survey No: 108
 Survey Date: 8/17/2005
 Survey Clients: Dorsey Village Condominiums

- GENERAL NOTES:**
- 1) SEE SHEET 2 & 3 FOR OVERALL DIMENSIONS OF BUILDINGS 9 & 10.
 - 2) ALL INTERIOR ANGLES OF CONDOMINIUMS ARE 90 DEGREES OR AS SHOWN.
 - 3) EACH CONDOMINIUM UNIT CONSIST OF SPACE BOUNDED BY A VERTICAL PROJECTION OF THE CONDOMINIUM UNIT BOUNDARY LINES AS SHOWN BY THE HORIZONTAL PLANES AT THE FLOOR AND CEILING ELEVATIONS OR AS SHOWN.

NO.	DATE	DESCRIPTION	BY

PROJECT DATA

FILE NAME: 03139.CONDDWG

SCALE: 1"=40'

DATE: MAY 2, 2005

CHECKED BY: O.Z.

DRAWN BY: P.P.

ENGINEER'S SEAL

SURVEYOR'S SEAL

LAND DESIGN & DEVELOPMENT, INC.

14407 WILLOW GROVE CIRCLE
 DORSEY VILLAGE LLC
 LOUISVILLE, KENTUCKY 40245
 PHONE: (502) 551-0569



SITE PLAN - BUILDINGS 9 & 10

03139

SHEET 1 OF 3

02x801

LEGEND
 10318 - UNIT NUMBER
 C.E.L. - CEILING ELEVATION
 --- LIMITS OF OWNERSHIP
 --- LIMITS OF COMMON SPACE (BUILDING EXTERIOR)

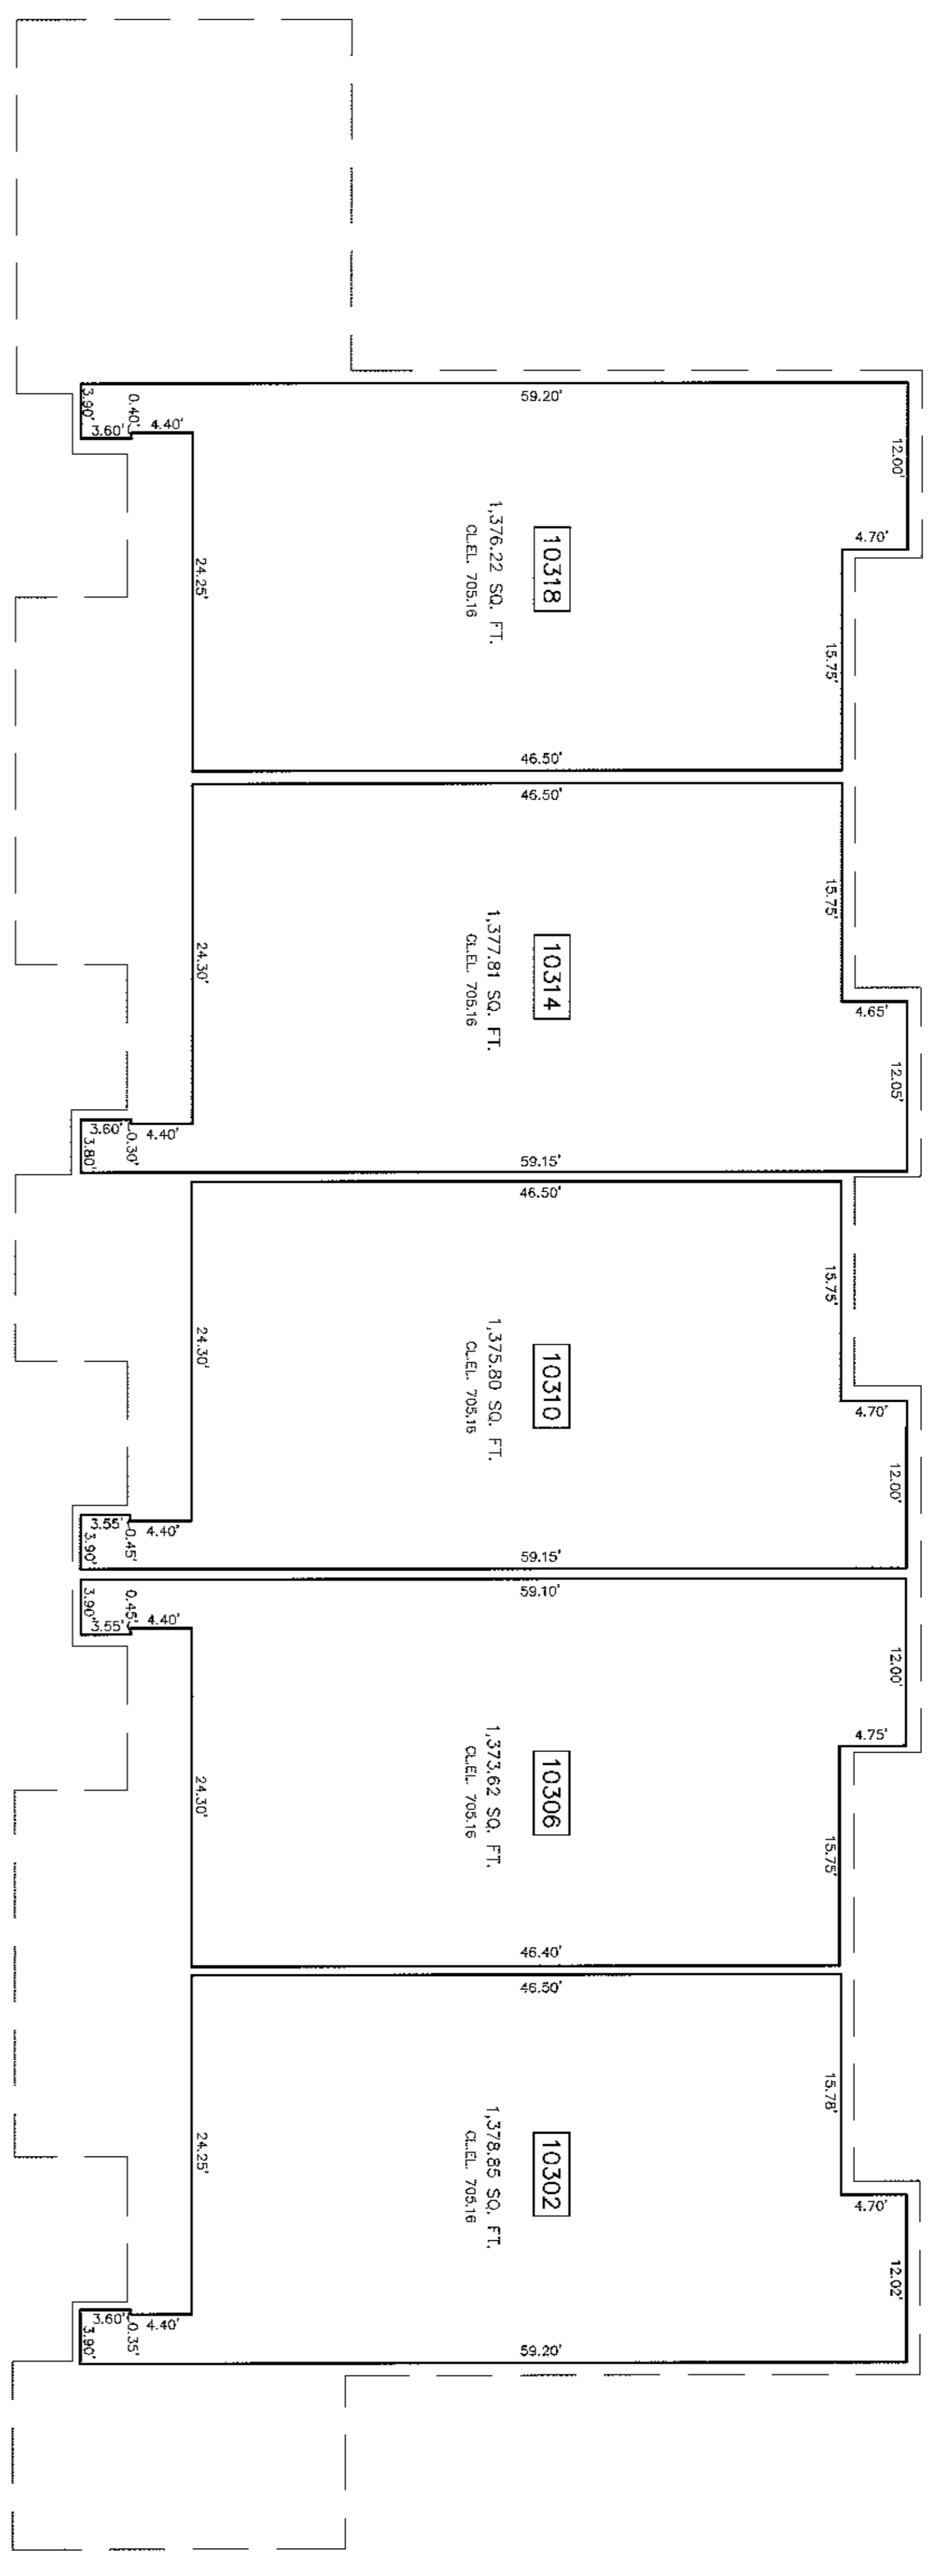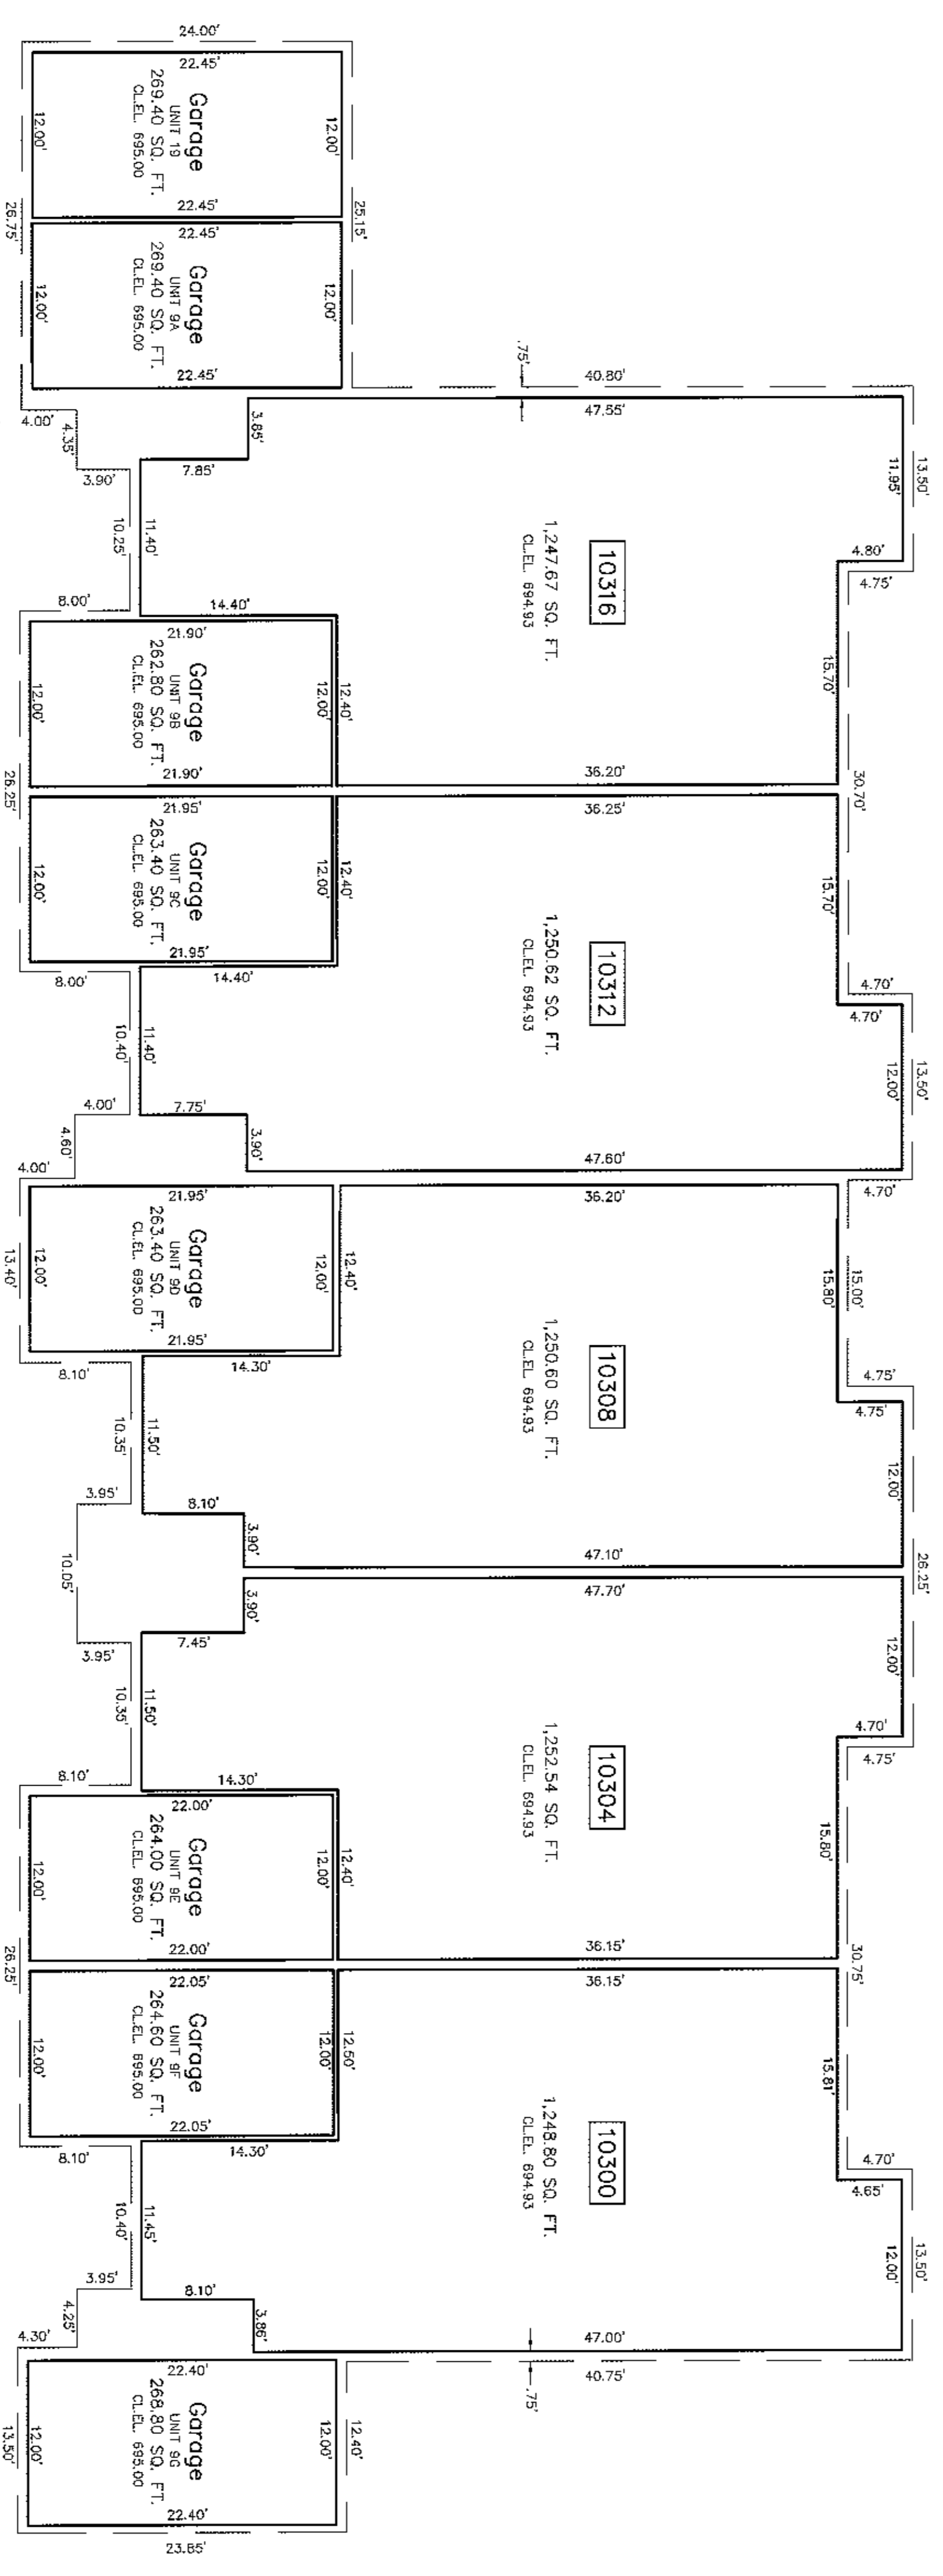

Recorded in Condo Book
 No. 108 Page 26
 Part No. 2012

Document No. 1-10000000000000000000
 Project No. 03139
 Date: 5/2/2005
 Author: JLD
 Checker: JLD
 Plotter: JLD

108 x 26

02 x 801

JOB NO. 03139	FLOOR PLAN - BUILDING "9" DORSEY VILLAGE CONDOMINIUMS	 LAND DESIGN & DEVELOPMENT, INC. ENGINEERING - LAND SURVEYING - LANDSCAPE ARCHITECTURE 2014 VINECREST AVENUE LOUISVILLE, KENTUCKY 40222 PHONE: 502.416-2914 FAX: 502.416-2975	PROJECT DATA FILE NAME: 03139\CONDO PLATS\BUILDING9.dwg DATE: MAY 2, 2005 SCALE: 1/8"=1'-0" CHECKED BY: O.Z. DRAWN BY: P.D.P.	ENGINEER'S SEAL	SURVEYOR'S SEAL	REVISIONS <table border="1"> <thead> <tr> <th>NO.</th> <th>DATE</th> <th>DESCRIPTION</th> <th>BY</th> </tr> </thead> <tbody> <tr><td> </td><td> </td><td> </td><td> </td></tr> <tr><td> </td><td> </td><td> </td><td> </td></tr> <tr><td> </td><td> </td><td> </td><td> </td></tr> <tr><td> </td><td> </td><td> </td><td> </td></tr> <tr><td> </td><td> </td><td> </td><td> </td></tr> </tbody> </table>	NO.	DATE	DESCRIPTION	BY																				
NO.	DATE		DESCRIPTION	BY																										
SHEET 2 OF 3	DEVELOPER: DORSEY VILLAGE LLC 14407 WILLOW GROVE CIRCLE LOUISVILLE, KENTUCKY 40245 PHONE: (502) 551-0569																													

108 x 26



108x27

LEGEND
 - UNIT NUMBER
 - CEILING ELEVATION
 - LIMITS OF OWNERSHIP
 - LIMITS OF COMMON SPACE (BUILDING EXTERIOR)

Recorded in County Book
 No. 0082470071
 Page 21
 2013

Recorded in County Book
 No. 0082470071
 Page 21
 2013

Recorded in County Book
 No. 0082470071
 Page 21
 2013

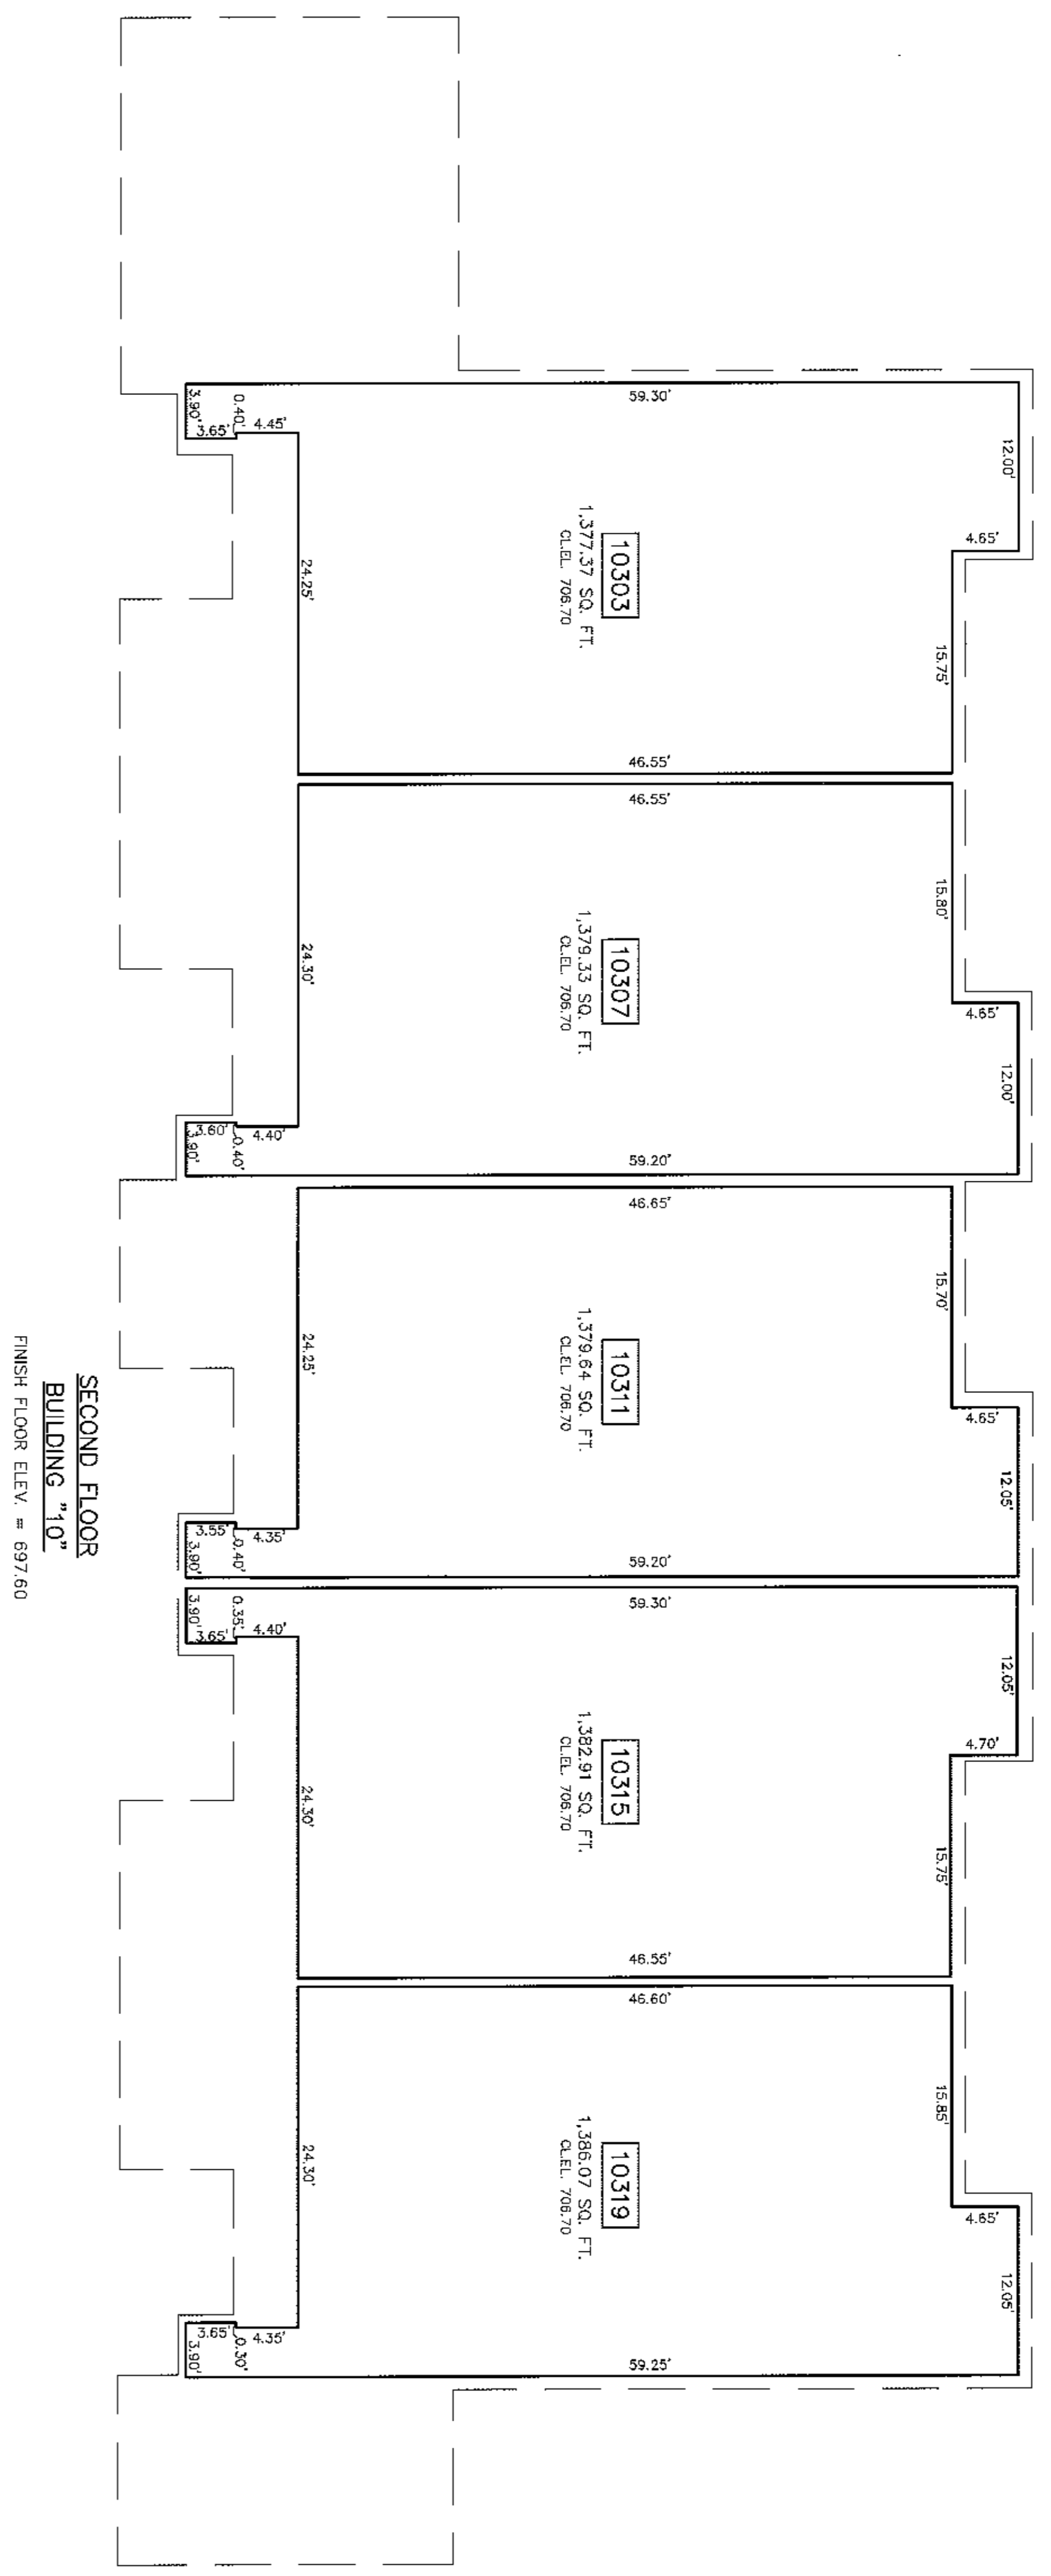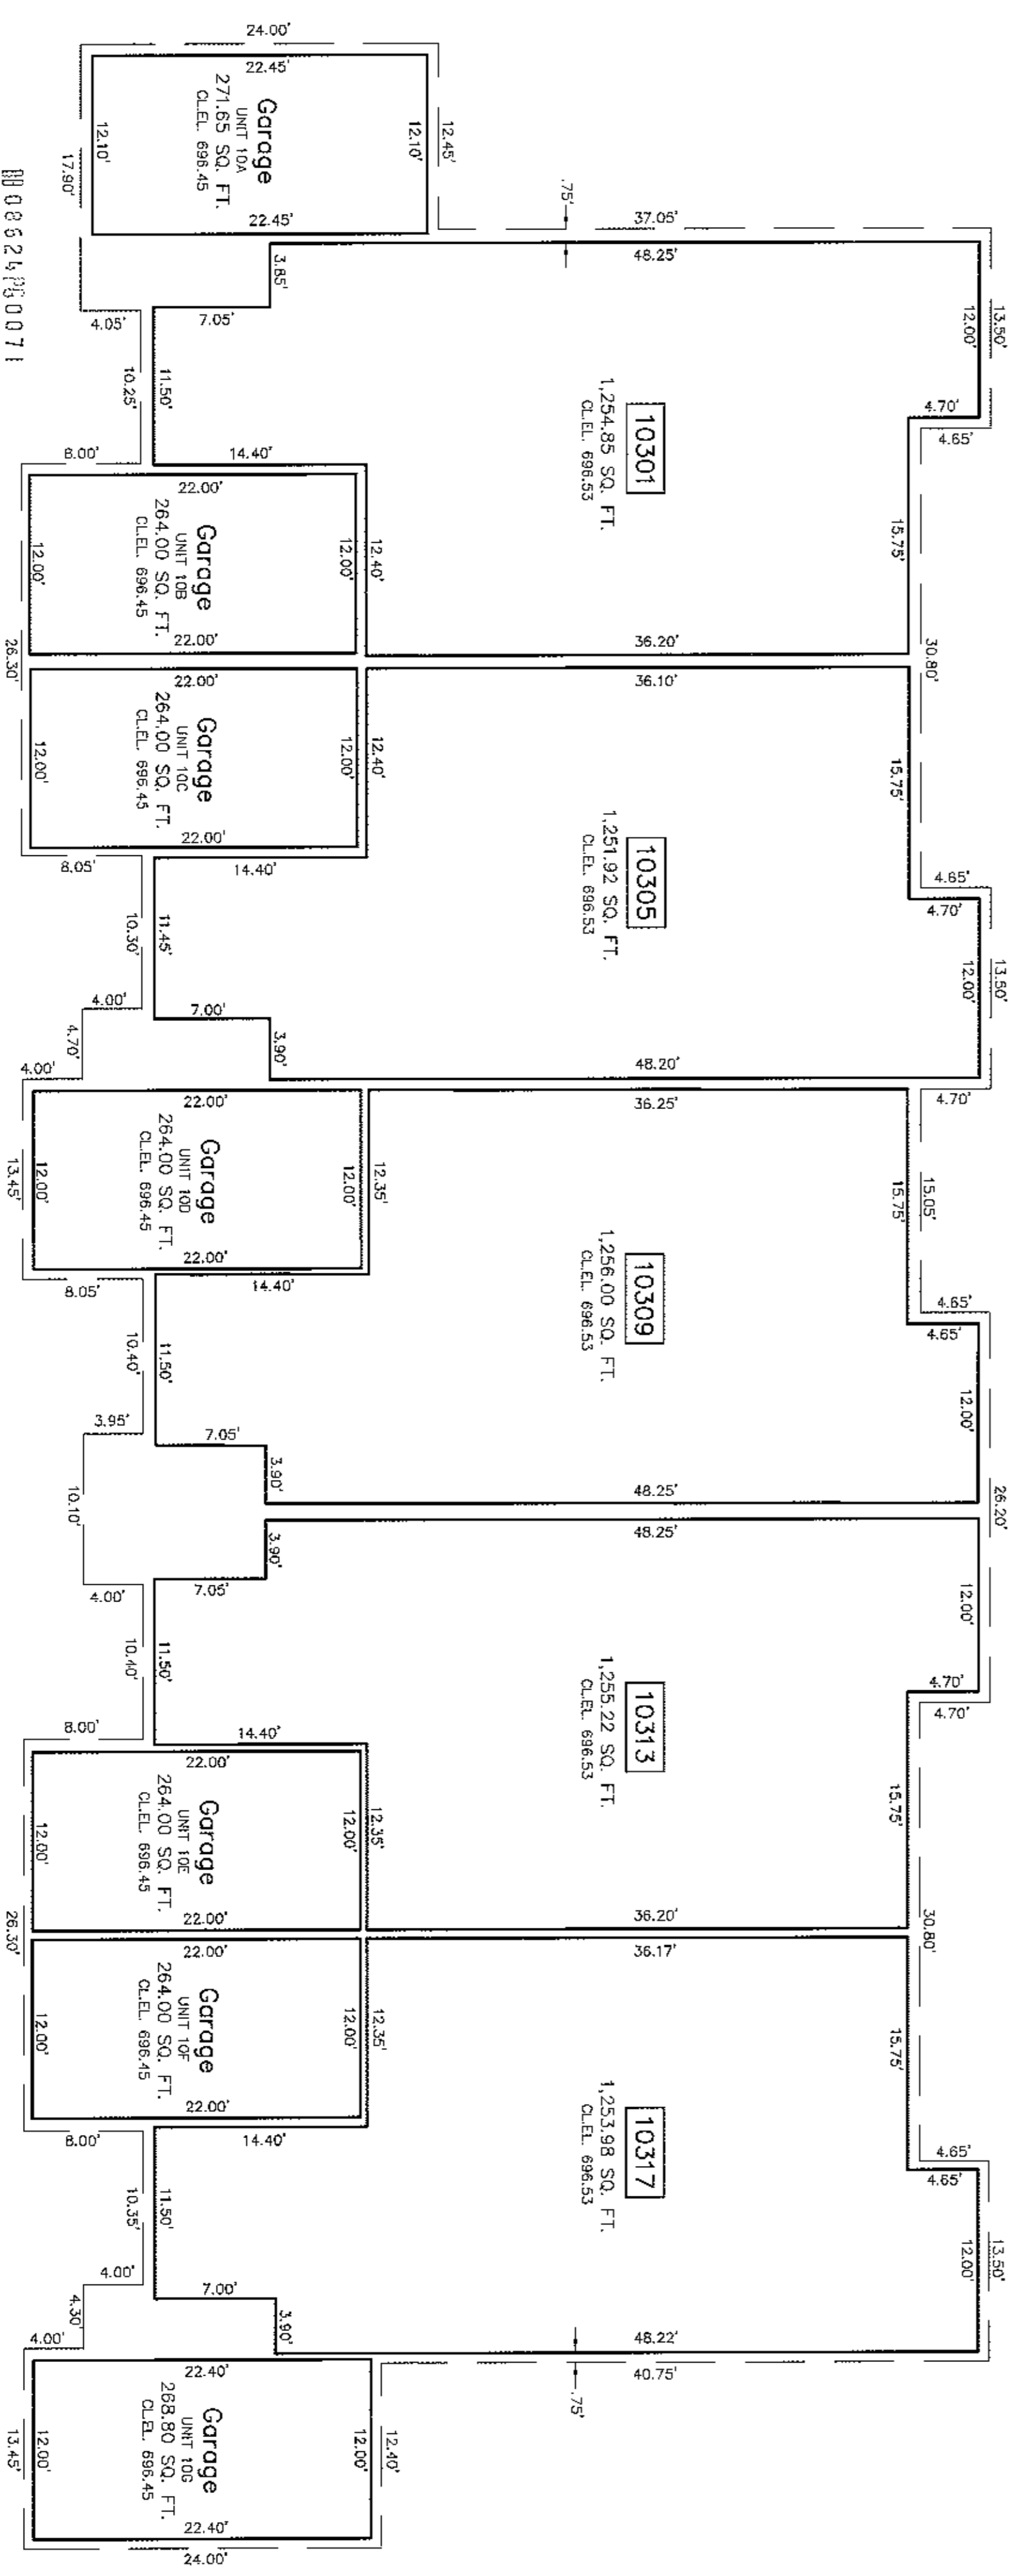

108x27

108x27

JOB NO.
03139

SHEET
3
OF 3

FLOOR PLAN - BUILDING "10"
DORSEY VILLAGE CONDOMINIUMS
 DEVELOPER:
 DORSEY VILLAGE LLC
 14407 WILLOW GROVE CIRCLE
 LOUISVILLE, KENTUCKY 40245
 PHONE: (502) 551-0569



PROJECT DATA
 FILE NAME: 03139/CONDG PLATS/BUILDING10.dwg
 DATE: MAY 2, 2005 SCALE: 1/8"=1'-0"
 CHECKED BY: O.Z. DRAWN BY: P.D.P.

REVISIONS			
NO.	DATE	DESCRIPTION	BY

ENGINEER'S SEAL SURVEYOR'S SEAL

108x27